COMMONWEALTH OF KENTUCKY
DEPARTMENT OF FINANCE
ENGINEERING STAFF

NEW FIRE ESCAPE & FIRE EXITS

CHERRY HALL
WESTERN KENTUCKY STATE COLLEGE
BOWLING GREEN KENTUCKY

FRANK D. CAIN A.I.A.
OLD MORGANTOWN RD., BOWLING GREEN, KY.
ARCHITECT

A-12

APPROVED BY Keely Thompson DATE 6/10/60
AGENCY HEAD

APPROVED BY _____ DATE JUL 11 19
CHIEF OF STAFF

R-369

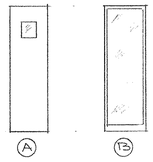

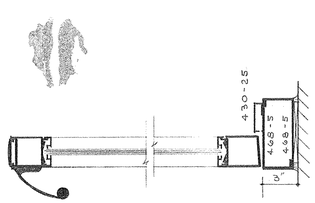

SECTION B-B

DOOR SCHEDULE								
MARK	SIZE	THICK	MATERIAL	TYPE	THRESHOLD	CLOSER	GLAZING	REMARKS
201	2-3'0x7'0	———	ALUM	B	ALUM	CLOS.	———	SEE DETAILS
202	2-3'0x7'0	1 3/4"	STEEL	A	———	CLOS	10"x10"	C-LABEL
203	2-2'-4x7'0	1 3/4"	STEEL	A	ALUM	CLOS.	10"x10"	= TO B-LABEL
301	2-3'0x7'0	1 3/4"	STEEL	A	———	CLOS.	10"x10"	C-LABEL
101	2-2'-4x7'0	1 3/4"	STEEL	A	ALUM	CLOS.	10"x10"	= TO B-LABEL
302	3'0x7'0	1 3/8	WOOD	THIS IS	THE DOOR REPLACED BY	FIREDOORS (301)		

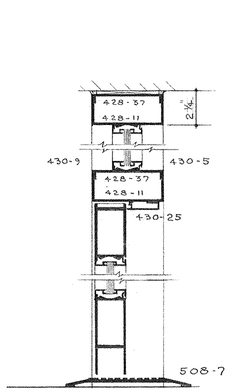

SECTION "A-A"

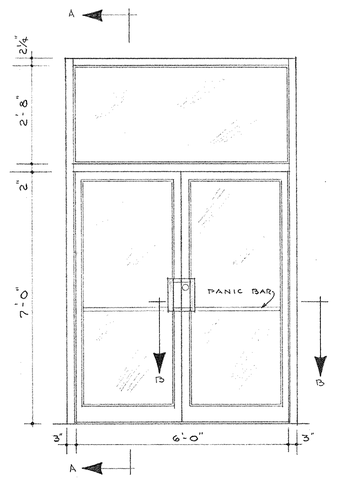

ELEVATION OF OUTSIDE DOORS

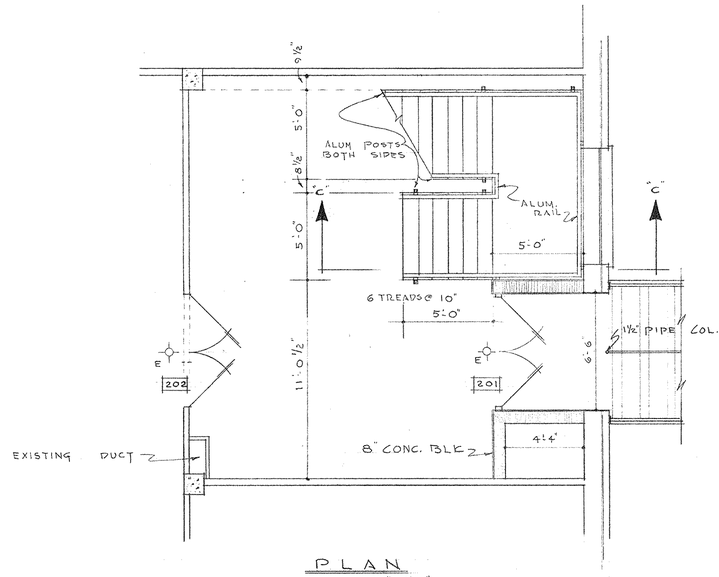

PLAN
SCALE 1/4" = 1'-0"

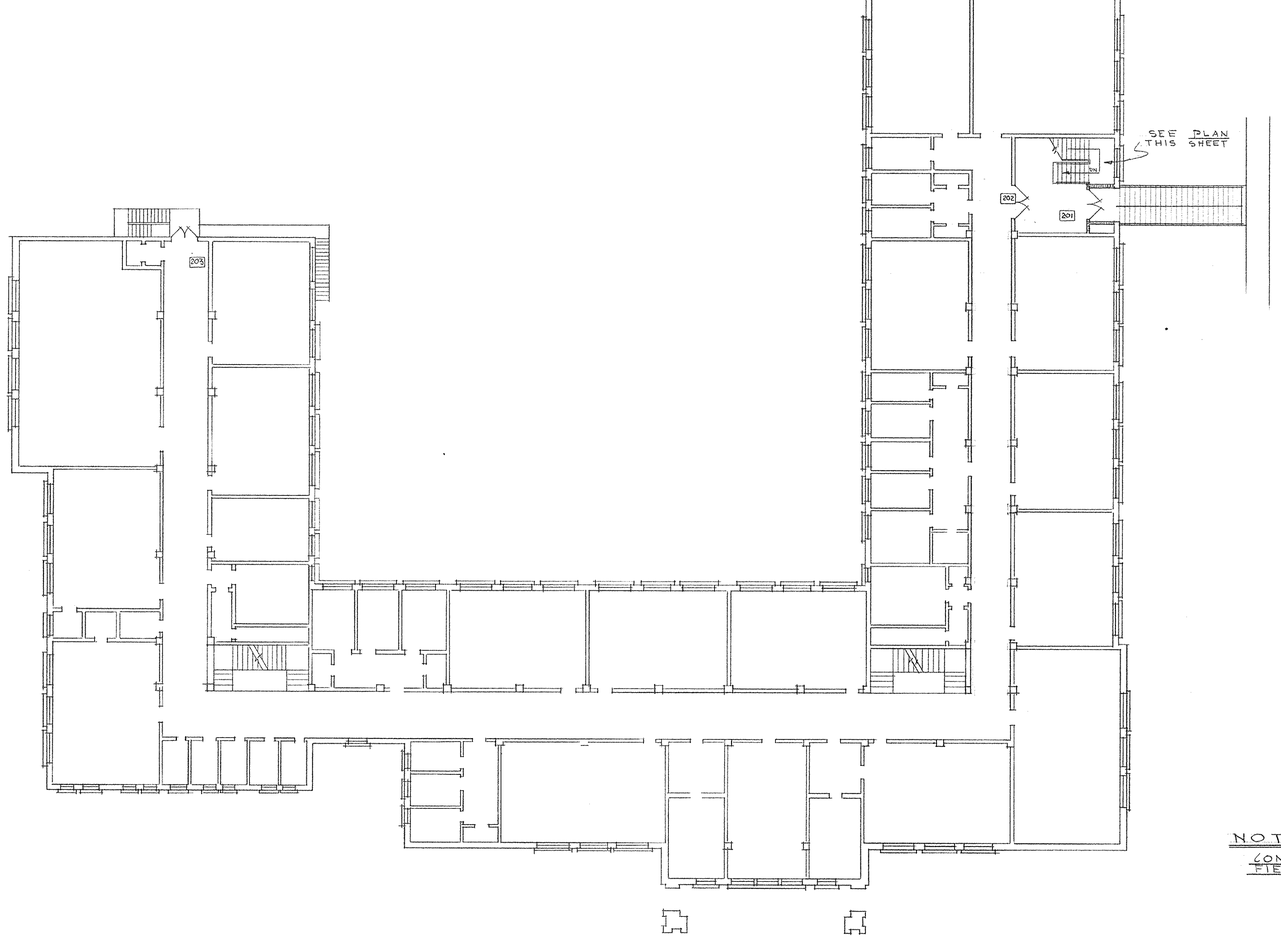

SECOND FLOOR PLAN
SCALE 1/16" = 1'-0"

SIDE ELEVATION
SCALE 1/8" = 1'-0"

NOTE:
CONTRACTOR SHALL BE RESPONSIBLE FOR FIELD CHECKING ALL DEMINSIONS

NEW FIRE ESCAPE & FIRE EXITS FOR
CHERRY HALL
WESTERN KENTUCKY STATE COLLEGE
BOWLING GREEN, KENTUCKY

R-12

DRAWN BY J.C.M.	PLAN & ELEVATIONS	DATE
TRACED BY	FRANK D. CAIN A.I.A. ARCHITECT BOWLING GREEN, KY.	SCALE AS NOTED
CHECKED BY F.D.C. & J.B.M		JOB NO. 6004
REVISION	COMMONWEALTH OF KENTUCKY DEPARTMENT OF FINANCE ENGINEERING STAFF FRANKFORT KENTUCKY	DRAWING NO. 1

APPROVED BY Leery Thompson AGENCY HEAD DATE 6/10/60

APPROVED BY [illegible] CHIEF OF STAFF DATE [illegible]

R 276

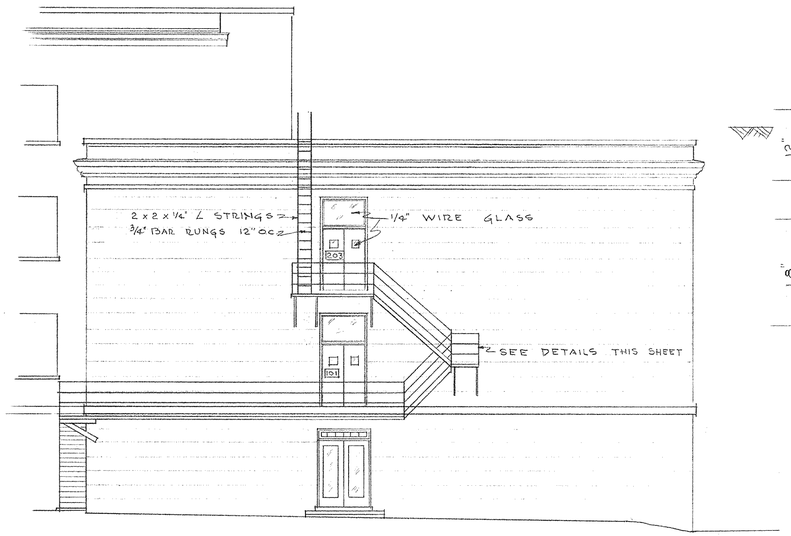

END ELEVATION
SCALE 1/8" = 1'-0"

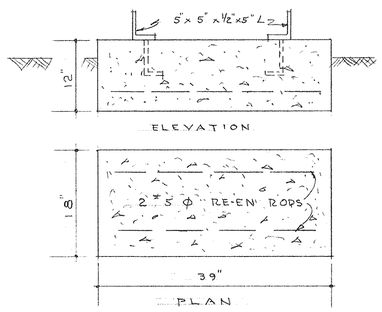

CONC. PAD

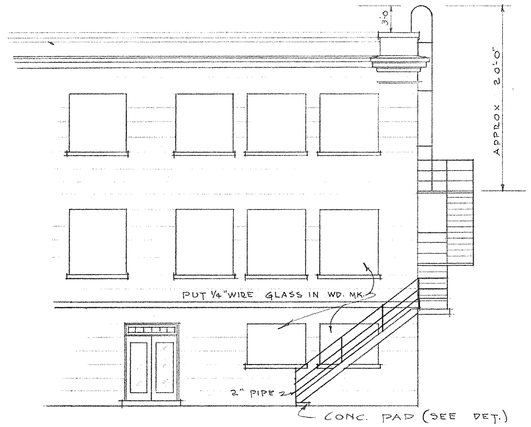

COURT SIDE ELEVATION
SCALE 1/8" = 1'-0"

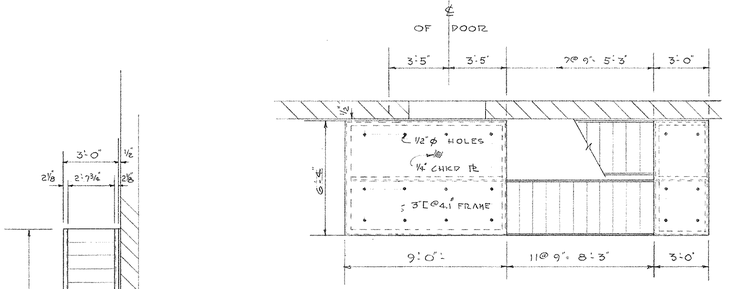

PLAN @ 3RD FLOOR
SCALE 1/4" = 1'-0"

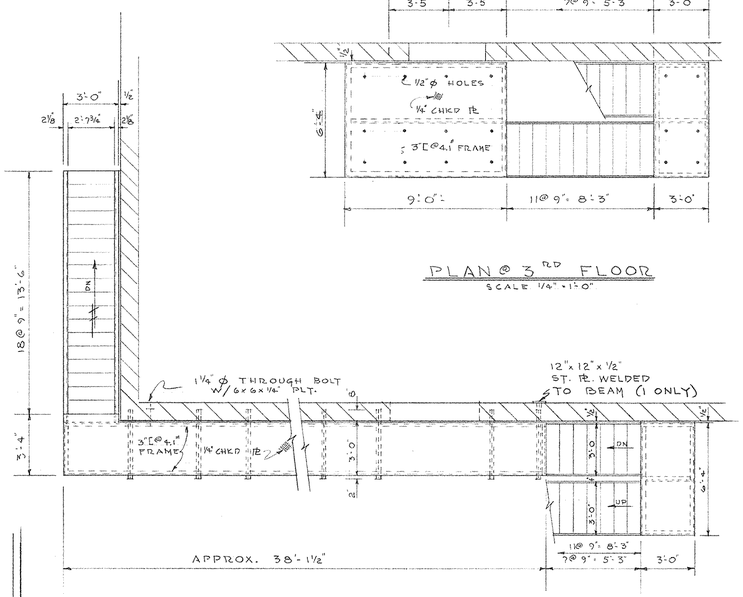

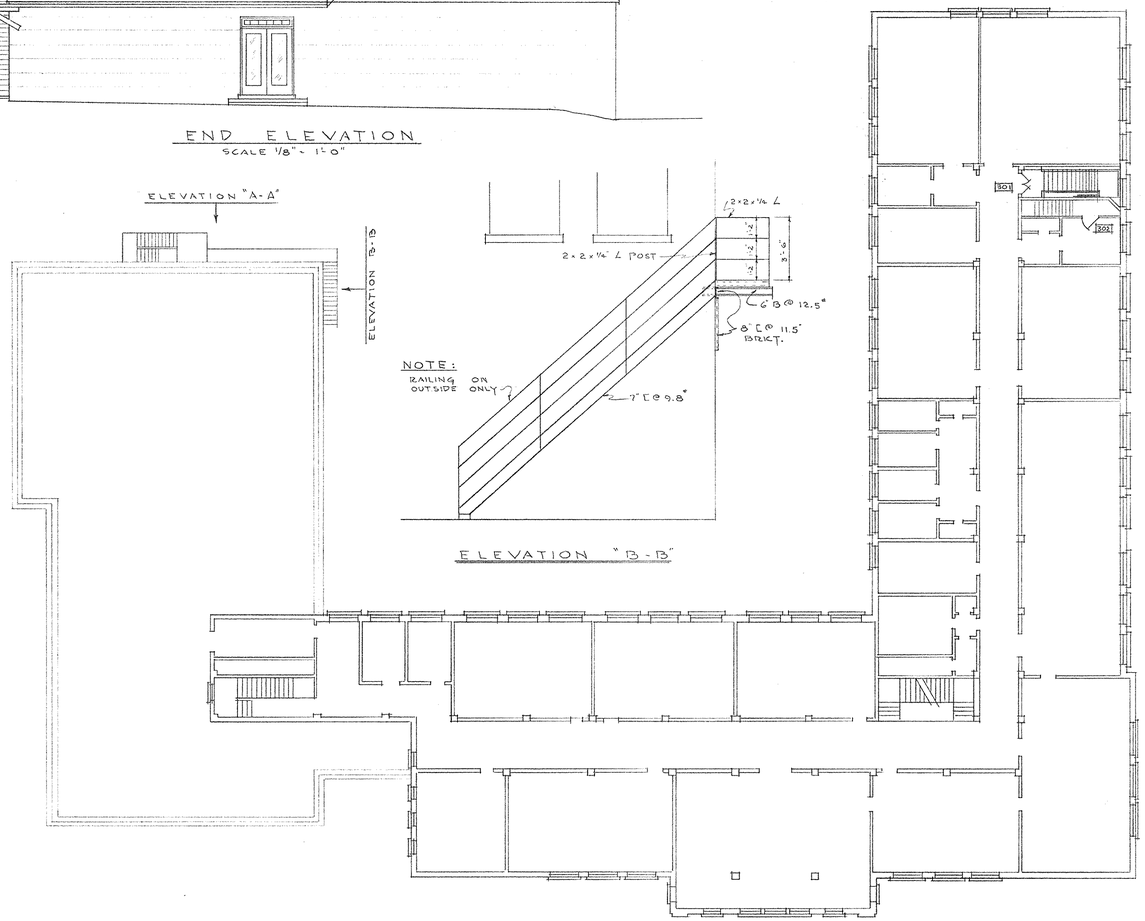

ELEVATION "B-B"

THIRD FLOOR PLAN
SCALE 1/16" = 1'-0"

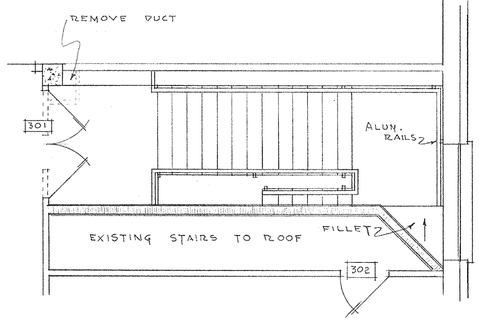

PLAN
SCALE 1/4" = 1'-0"

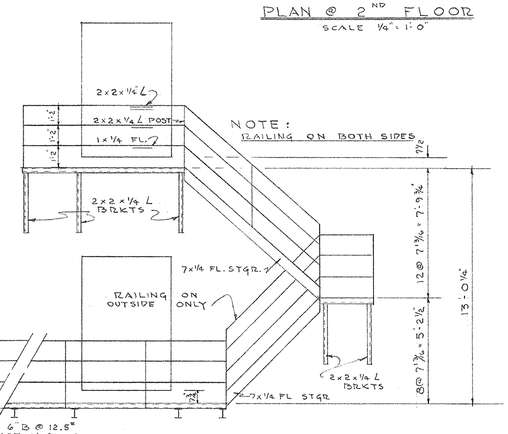

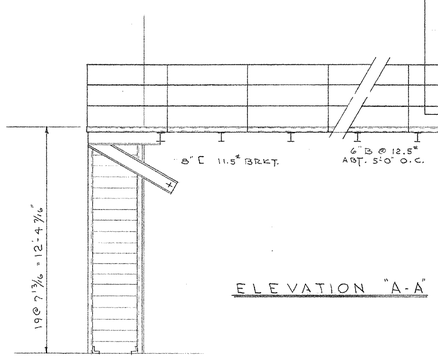

ELEVATION "A-A"

PLAN @ 2ND FLOOR
SCALE 1/4" = 1'-0"

NEW FIRE ESCAPE & FIRE EXITS FOR
CHERRY HALL
WESTERN KENTUCKY STATE COLLEGE
BOWLING GREEN, KENTUCKY

A-13

DRAWN BY J. C. M.	PLAN & ELEVATIONS	DATE
TRACED BY	FRANK D. CAIN A.I.A. ARCHITECT BOWLING GREEN, KY.	SCALE AS NOTED
CHECKED BY F.D.C. & J.B.M.		JOB NO 6004
REVISION	COMMONWEALTH OF KENTUCKY DEPARTMENT OF FINANCE ENGINEERING STAFF FRANKFORT KENTUCKY	DRAWING NO. 2

APPROVED BY Keen Thompson AGENCY HEAD DATE 6/10/60

APPROVED BY David L. Pitts CHIEF OF STAFF DATE JUL 11 1960

R-371

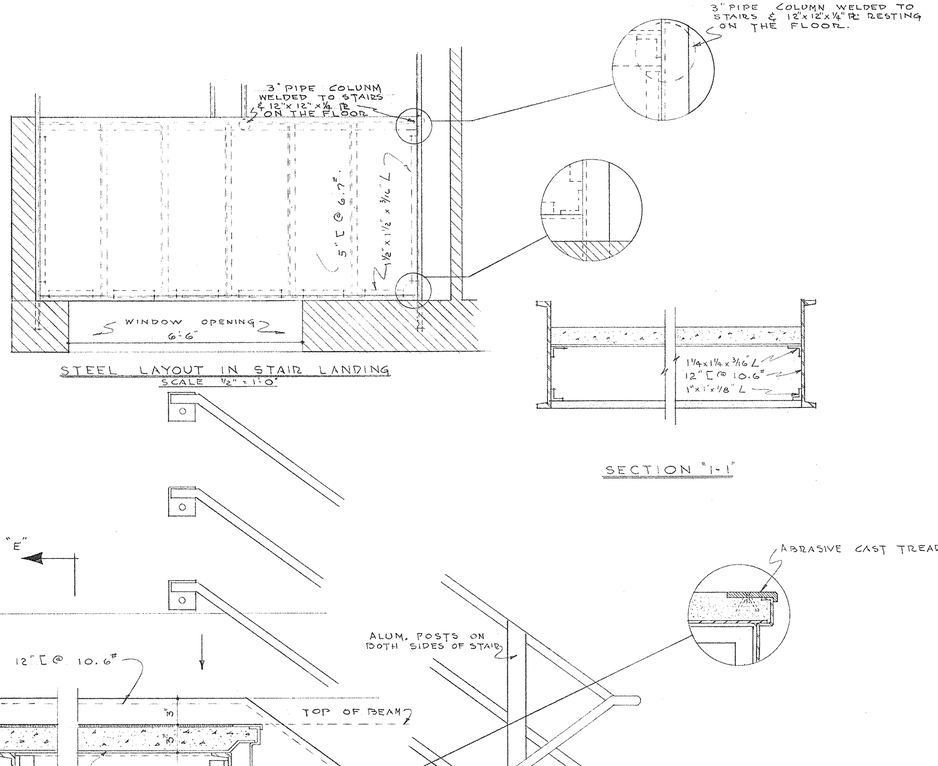

STEEL LAYOUT IN STAIR LANDING
SCALE ½" = 1'-0"

SECTION "1-1"

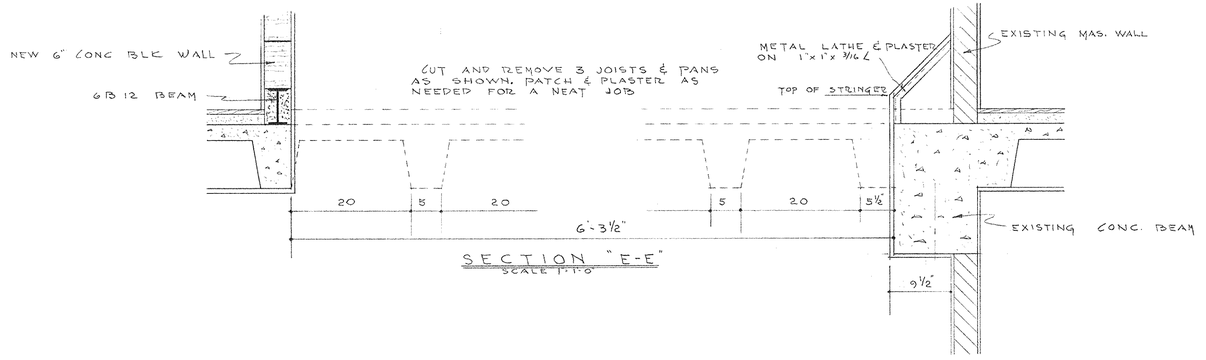

SECTION "E-E"
SCALE 1"=1'-0"

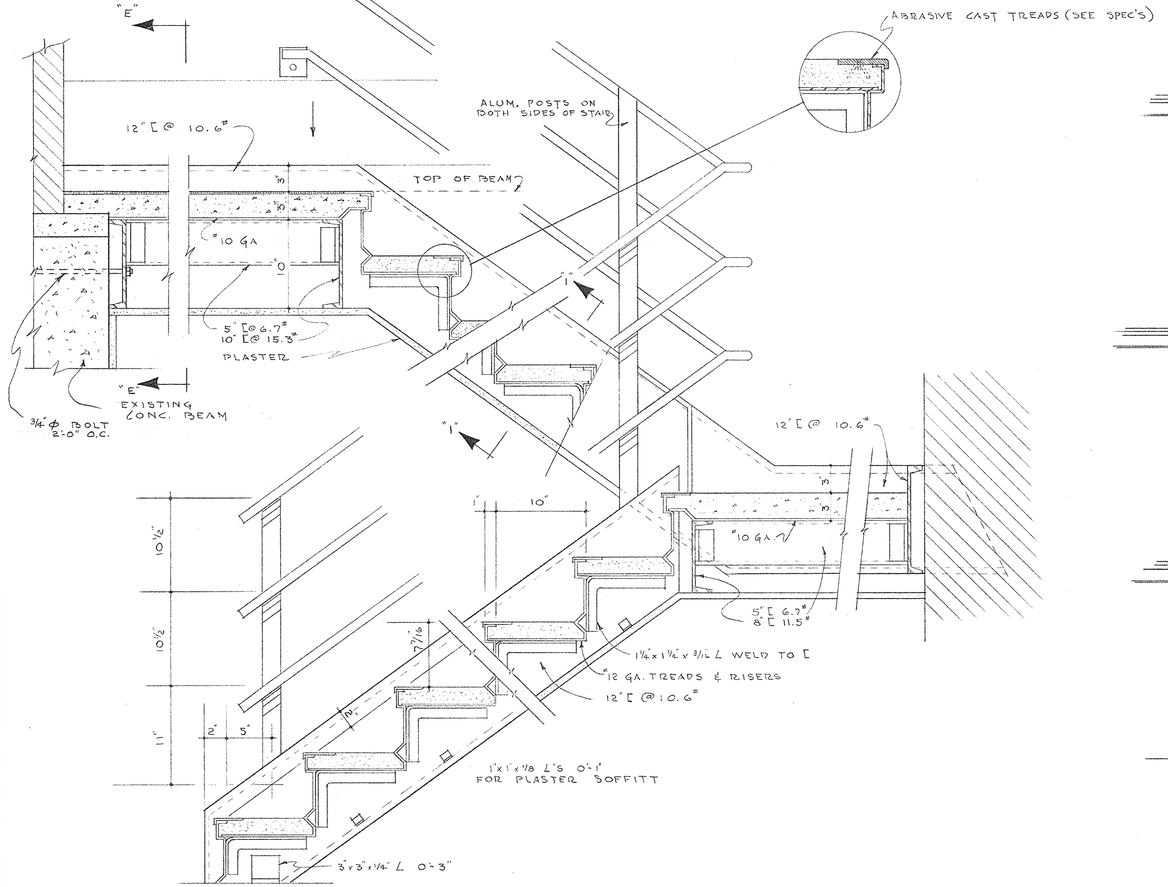

SECTION "C-C"
SCALE 1½"=1'-0"

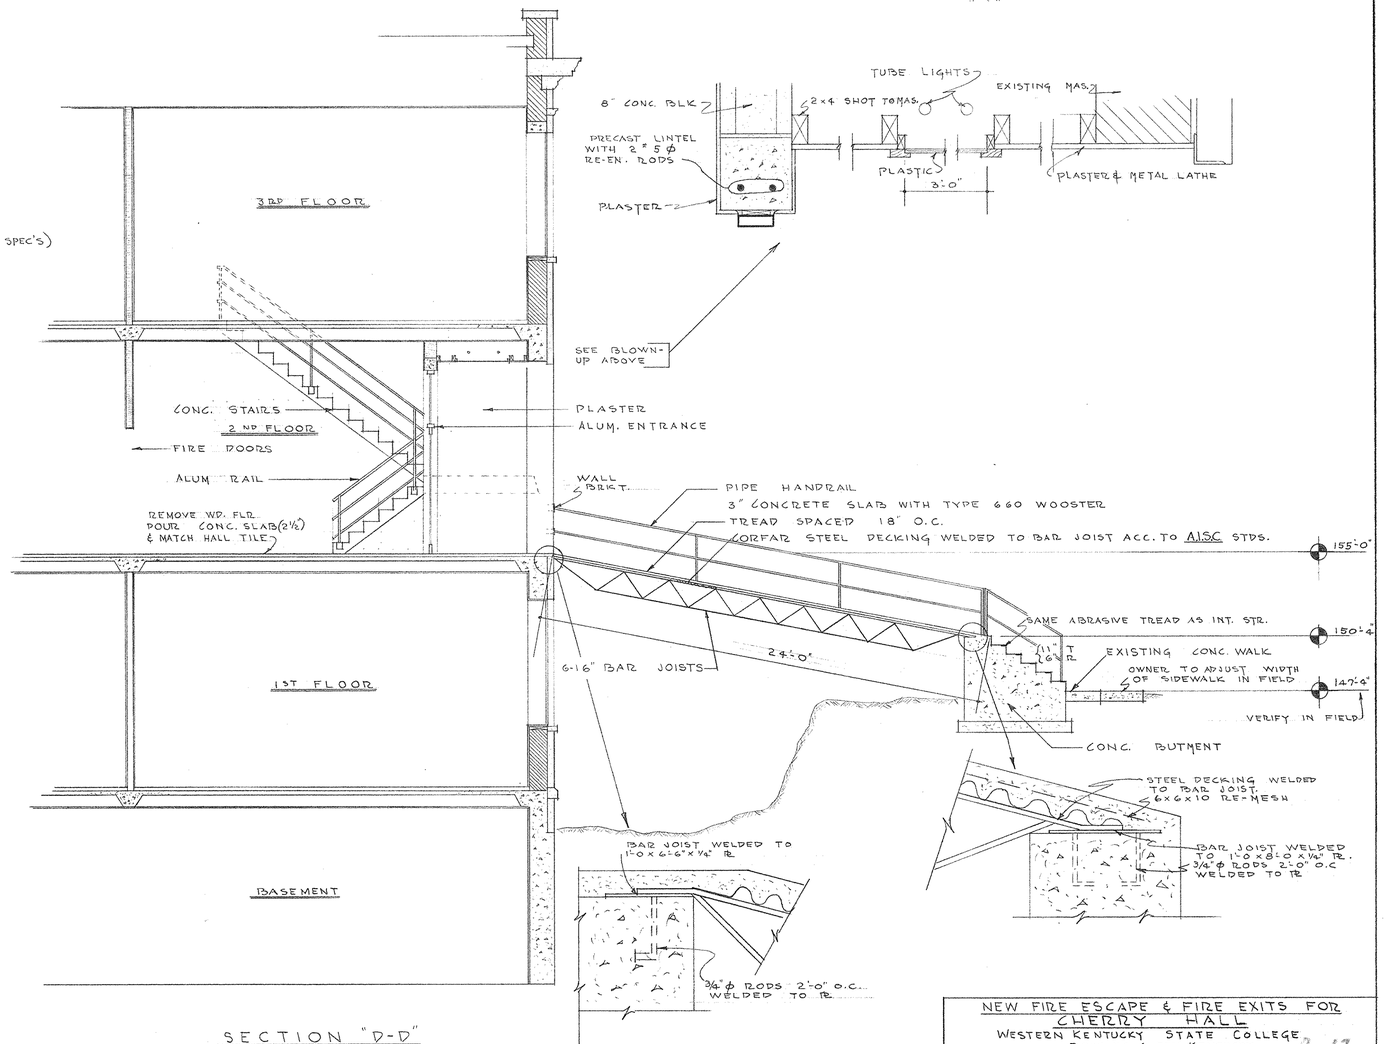

SECTION "D-D"
SCALE 1½"=1'-0"

NEW FIRE ESCAPE & FIRE EXITS FOR
CHERRY HALL
WESTERN KENTUCKY STATE COLLEGE
BOWLING GREEN, KENTUCKY

R-12

DRAWN BY J.C.M	DETAILS	DATE
TRACED BY	FRANK D CAIN A.I.A. ARCHITECT BOWLING GREEN, KY.	SCALE AS NOTED
CHECKED BY F.D.C. & J.B.M.		JOB NO. 6004
REVISION	COMMONWEALTH OF KENTUCKY DEPARTMENT OF FINANCE ENGINEERING STAFF FRANKFORT KENTUCKY	DRAWING NO. 3

APPROVED BY Kelly Thompson AGENCY HEAD DATE 6/19/80

APPROVED BY David L. Porter CHIEF OF STAFF DATE JUL 11 1980

R-372

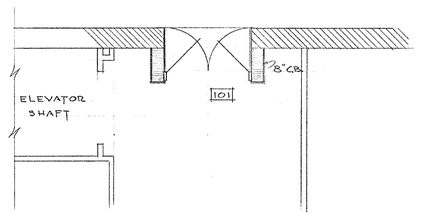

PLAN DOOR 101
SCALE 1/4" = 1'-0"

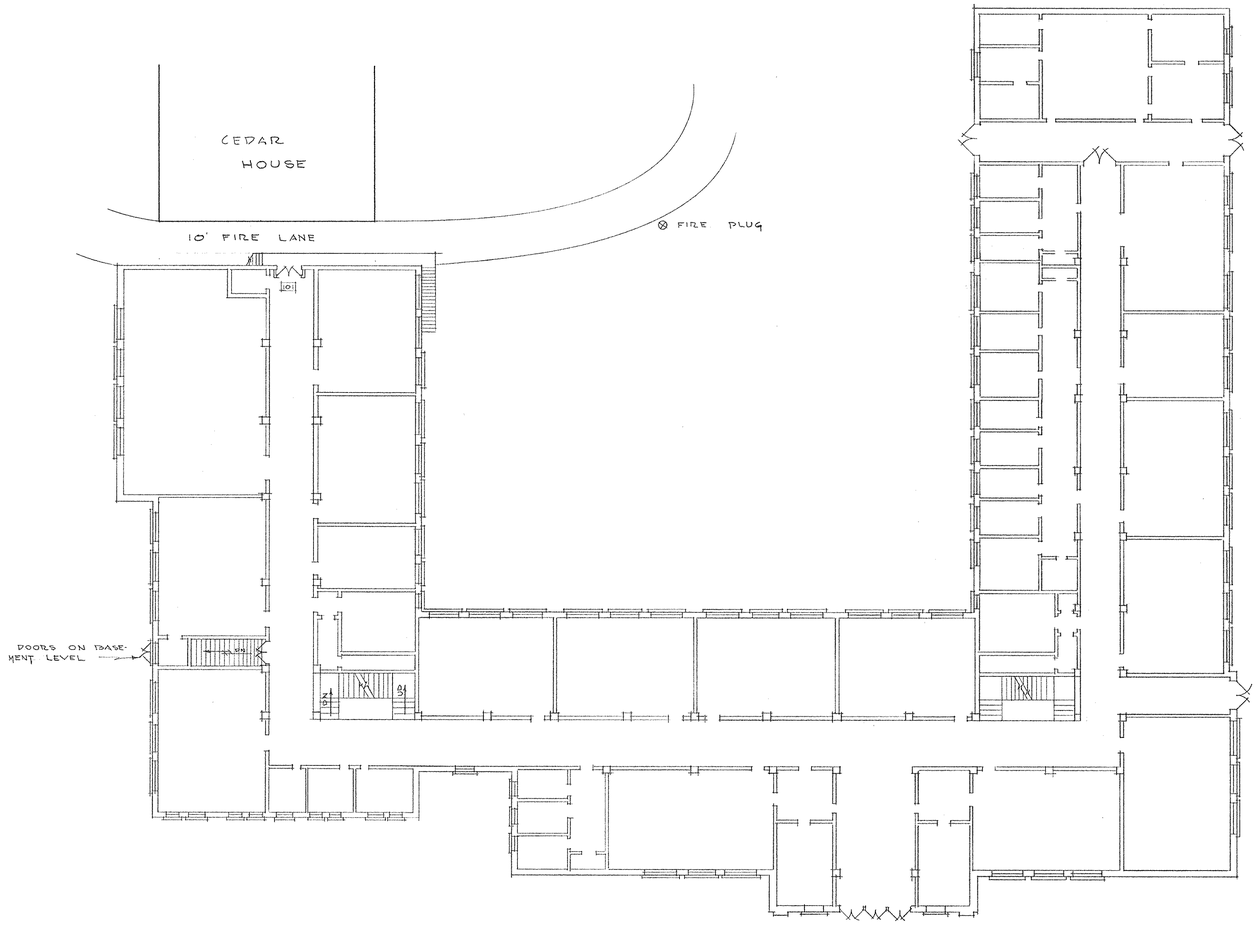

FIRST FLOOR PLAN
SCALE 1/16" = 1'-0"

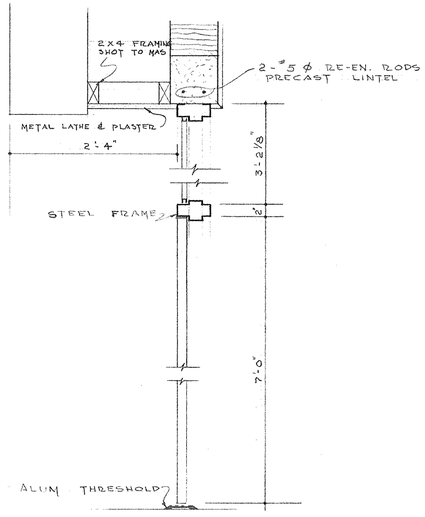

SECTION THRU DR. 101
SCALE 1" = 1'-0"

NEW FIRE ESCAPE & FIRE EXITS FOR
CHERRY HALL
WESTERN KENTUCKY STATE COLLEGE
BOWLING GREEN, KENTUCKY

DRAWN BY J.C.M.	PLAN & ELEVATIONS	DATE
TRACED BY	FRANK D. CAIN A.I.A. ARCHITECT BOWLING GREEN, KY.	SCALE AS NOTED
CHECKED BY F.D.C. & J.B.M.		JOB NO 6004
REVISION	COMMONWEALTH OF KENTUCKY DEPARTMENT OF FINANCE ENGINEERING STAFF FRANKFORT KENTUCKY	DRAWING NO. 4

APPROVED BY _____ AGENCY HEAD DATE _____

APPROVED BY David L. Patterson CHIEF OF STAFF DATE JUL 11 1960

R-373

COMMONWEALTH OF KENTUCKY

DEPARTMENT OF FINANCE

DIVISION OF ENGINEERING

RENOVATION OF CHERRY HALL

WESTERN KENTUCKY UNIVERSITY

BOWLING GREEN, KENTUCKY

FRANK D. CAIN, JR. AIA ARCHITECT

BOWLING GREEN KENTUCKY

ARCH · STRUCT

R-2343

LEGEND

- EXISTING WALL
- REMOVED EXIST. WALL
- CORNICE HEIGHT PARTITION (EXIS.)
- REMOVED CORNICE HEIGHT PARTITION
- EXISTING WOOD STUD WALL WITH WIRE COVERING ONE SIDE
- REMOVED OR ALTERED MISC. ITEM
- CLOSE EXISTING DOOR (OR OPENING)
- NEW DOOR IN EXISTING WALL
- NEW STONE
- NEW DEMOUNTABLE PARTITION
- NEW CONCRETE BLOCK
- NEW CONCRETE
- NEW FIELD STONE WALL
- CRUSHED STONE
- STEEL
- NEW BRICK WALL
- RIGID INSULATION
- BATT INSULATION
- EARTH
- STRUCTURAL OR ROUGH WOOD FRAMING
- OFFICE — ROOM IDENTIFICATION
- A / A-6 — DETAIL & SECTION REFERENCES
- ELEVATION & REFERENCES
- INSULATED METAL WALL PANEL

NOTE:

THE FOLLOWING SYMBOLS INDICATE THE DISPOSITION AND HANDLING OF VARIOUS ITEMS IN THE BUILDING AT THE TIME WORKING DRAWINGS WERE PREPARED. THESE ITEMS SHOWN DO NOT RELIEVE THE CONTRACTOR OF HIS RESPONSIBILITY TO HANDLE ANY ITEM NOT SHOWN IN ACCORDANCE WITH THE CONTRACT DRAWINGS, SPECIFICATIONS AND DOCUMENTS.

- ●----- TO REMAIN & BE PROTECTED BY CONTRACTOR. REFINISH AS INDICATED AND/OR SPECIFIED.
- ◆----- TO BE REMOVED, PROTECTED AND DELIVERED TO OWNER AT SITE.
- ■----- TO BE REMOVED BY OWNER PRIOR TO CONSTRUCTION.
- ▲------ TO BE REMOVED FROM SITE BY CONTRACTOR.
- ●----- TO BE RELOCATED IN BUILDING BY CONTRACTOR. REFINISH AS INDICATED AND/OR SPECIFIED.

ABBREVIATIONS:

E.C.B.	EXISTING CHALK BOARD
E.T.B.	EXISTING TACK BOARD
E.F.E.	EXISTING FIRE EXTINGUISHER
E.E.W.C.	EXISTING ELECTRIC WATER COOLER
E.W.C.	NEW ELECTRIC WATER COOLER
C	NEW CHALK BOARD
T	NEW TACK BOARD

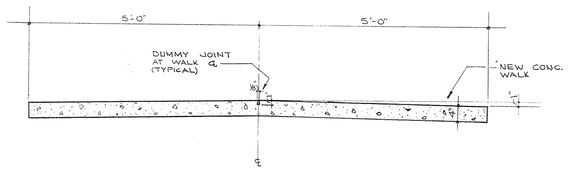

TYPICAL SLOPED WALKWAY DETAIL (C / A-1)
SCALE: 3/4" = 1'-0"

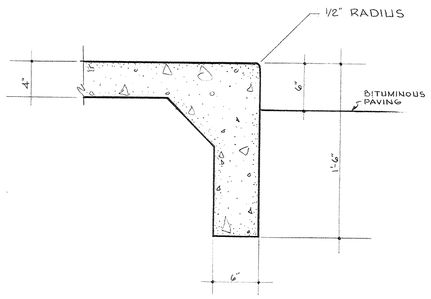

INTERGRAL CURB DETAIL (A / A-1)
SCALE: 1 1/2" = 1'-0"

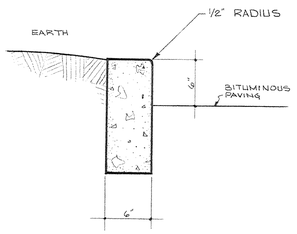

TYPICAL CURB DETAIL (B / A-1)
SCALE: 1 1/2" = 1'-0"

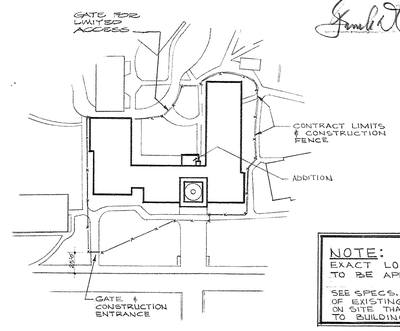

CONSTRUCTION FENCE LOCATION
SCALE: 1" = 100'-0"

NOTE:
EXACT LOCATION OF FENCE TO BE APPROVED BY OWNER.

SEE SPECS. FOR SAND BLASTING OF EXISTING STONE IMPROVEMENTS ON SITE THAT ARE NOT ATTACHED TO BUILDING.

I certify that these are AS BUILT DRAWINGS to the best of my knowledge and belief.
Frank D. Cain

FRANK D. CAIN JR. REGISTERED No. 228 COMMONWEALTH OF KENTUCKY ARCHITECT

SCHEDULE OF DRAWINGS

ARCHITECTURAL

A-1	SCHEDULE OF DRAWINGS, LEGEND & DETAILS
SS-1	SITE SURVEY
A-2	SITE DEVELOPMENT PLAN
A-3	EXISTING FLOOR PLANS
A-4	BASEMENT FLOOR PLAN
A-5	FIRST FLOOR PLAN
A-6	SECOND FLOOR PLAN
A-7	THIRD FLOOR PLAN
A-8	ROOF PLAN
A-9	ELEVATIONS
A-10	ELEVATIONS
A-11	ELEVATIONS
A-12	SECTIONS
A-13	SECTIONS
A-14	SECTIONS
A-15	SECTIONS
A-16	STAIR #1 - PLAN, SECTION & DETAILS
A-17	STAIR #2 - PLANS, SECTION & DETAILS
A-18	ROOM FINISH SCHEDULE
A-19	ROOM FINISH SCHEDULE
A-20	DOOR SCHEDULE
A-21	DOOR SCHEDULE
A-22	EXISTING DETAILS

STRUCTURAL

S-1	LOBBY & ELEVATOR PLAN
S-2	LOBBY & ELEVATOR DETAILS
S-3	STAIR PLANS & DETAILS
S-4	PENTHOUSE PLANS & DETAILS

MECHANICAL

M-1	BASEMENT
M-2	FIRST FLOOR
M-3	SECOND FLOOR
M-4	THIRD FLOOR
M-5	ROOF
M-6	BASEMENT
M-7	FIRST FLOOR
M-8	SECOND FLOOR
M-9	THIRD FLOOR
M-10	BASEMENT MECHANICAL ROOM
M-11	P.H. DETAIL A.H.U. NO.1
M-12	P.H. DETAIL A.H.U. NO.2
M-13	SECTIONS, DETAILS
M-14	SECTIONS, DETAILS
M-15	DETAILS & SCHEDULES
M-16	DETAILS & SCHEDULES

ELECTRICAL

E-1	BASEMENT LIGHTING
E-2	BASEMENT RECEPTACLES
E-3	FIRST FLOOR LIGHTING
E-4	FIRST FLOOR RECEPTACLES
E-5	SECOND FLOOR LIGHTING
E-6	SECOND FLOOR RECEPTACLES
E-7	THIRD FLOOR LIGHTING
E-8	THIRD FLOOR RECEPTACLES
E-9	ROOF PLAN
E-10	MECHANICAL ROOM PLANS
E-11	ELECTRICAL DIAGRAMS
E-12	EXISTING BASEMENT LIGHTING
E-13	EXISTING FIRST FLOOR LIGHTING
E-14	EXISTING SECOND FLOOR LIGHTING
E-15	EXISTING THIRD FLOOR LIGHTING

RENOVATION OF CHERRY HALL
WESTERN KENTUCKY UNIVERSITY
BOWLING GREEN, KENTUCKY

DRAWN T.D.C. B.F.	SCHEDULE & LEGEND	DATE 4-3-72
TRACED S.D.	FRANK D. CAIN JR., A. I. A. ARCHITECT, BOWLING GREEN, KENTUCKY	SCALE AS NOTED
CHECKED F.D.C.		SPEC. NO. 7201
	COMMONWEALTH OF KENTUCKY DEPARTMENT OF FINANCE DIVISION OF ENGINEERING FRANKFORT, KENTUCKY	DRAWING NO. A-1 OF 22

APPROVED BY _____ AGENCY HEAD _____ DATE APR 6 1972
APPROVED BY _____ CHIEF OF STAFF _____ DATE 4-4-72

R-2344

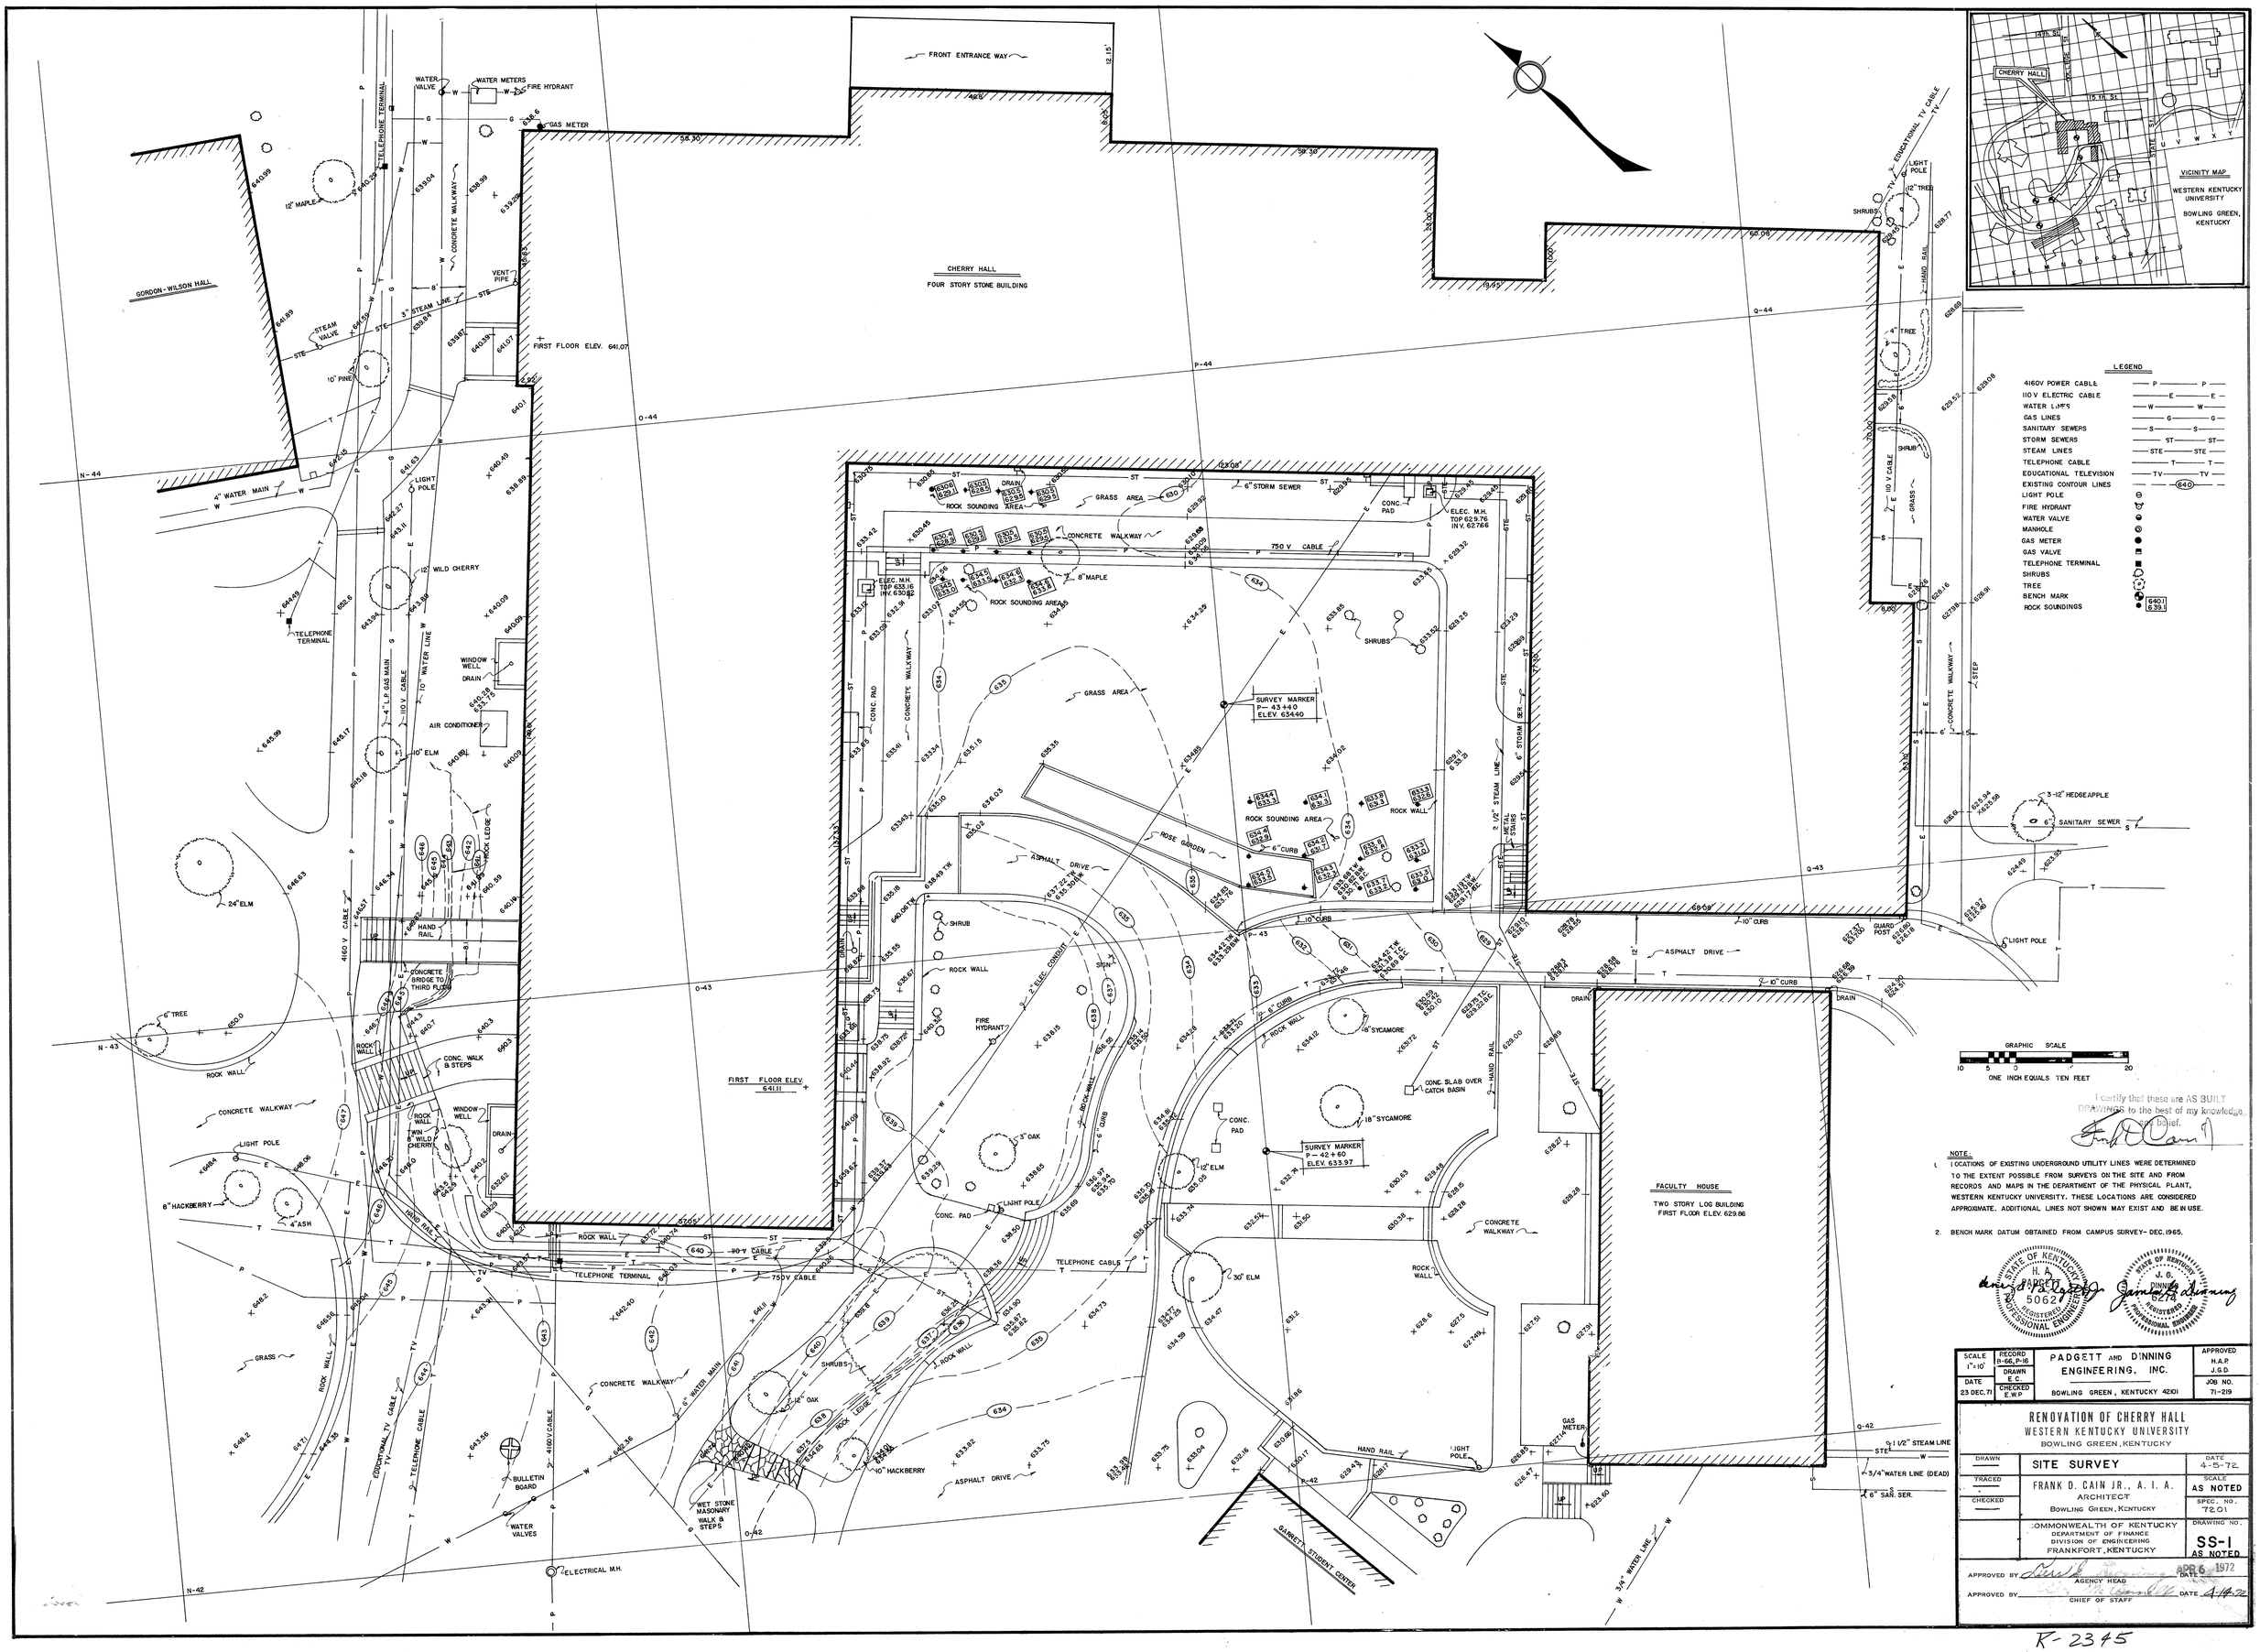

LEGEND

4160V POWER CABLE	—P—P—
110V ELECTRIC CABLE	—E—E—
WATER LINES	—W—W—
GAS LINES	—G—G—
SANITARY SEWERS	—S—S—
STORM SEWERS	—ST—ST—
STEAM LINES	—STE—STE—
TELEPHONE CABLE	—T—T—
EDUCATIONAL TELEVISION	—TV—TV—
EXISTING CONTOUR LINES	—640—
LIGHT POLE	⊖
FIRE HYDRANT	
WATER VALVE	
MANHOLE	
GAS METER	
GAS VALVE	
TELEPHONE TERMINAL	
SHRUBS	
TREE	
BENCH MARK	640.1 639.1
ROCK SOUNDINGS	

GRAPHIC SCALE
10 5 0 10 20
ONE INCH EQUALS TEN FEET

I certify that these are AS BUILT DRAWINGS to the best of my knowledge and belief.

NOTE:
1. LOCATIONS OF EXISTING UNDERGROUND UTILITY LINES WERE DETERMINED TO THE EXTENT POSSIBLE FROM SURVEYS ON THE SITE AND FROM RECORDS AND MAPS IN THE DEPARTMENT OF THE PHYSICAL PLANT, WESTERN KENTUCKY UNIVERSITY. THESE LOCATIONS ARE CONSIDERED APPROXIMATE. ADDITIONAL LINES NOT SHOWN MAY EXIST AND BE IN USE.
2. BENCH MARK DATUM OBTAINED FROM CAMPUS SURVEY- DEC. 1965.

H. A. PADGETT 5062 REGISTERED PROFESSIONAL ENGINEER
J. G. DINNING 5274 REGISTERED PROFESSIONAL ENGINEER

SCALE 1"=10'	RECORD B-66, P-16	PADGETT AND DINNING ENGINEERING, INC.	APPROVED H.A.P. J.G.D.
DATE 23 DEC. 71	DRAWN E.C. CHECKED E.W.P.	BOWLING GREEN, KENTUCKY 42101	JOB NO. 71-219

RENOVATION OF CHERRY HALL
WESTERN KENTUCKY UNIVERSITY
BOWLING GREEN, KENTUCKY

DRAWN	SITE SURVEY		DATE 4-5-72
TRACED	FRANK D. CAIN JR., A. I. A. ARCHITECT BOWLING GREEN, KENTUCKY		SCALE AS NOTED
CHECKED			SPEC. NO. 72.01
	COMMONWEALTH OF KENTUCKY DEPARTMENT OF FINANCE DIVISION OF ENGINEERING FRANKFORT, KENTUCKY		DRAWING NO. SS-1 AS NOTED

APPROVED BY _____ AGENCY HEAD DATE APR 6 1972
APPROVED BY _____ CHIEF OF STAFF DATE 4-14-72

K-2345

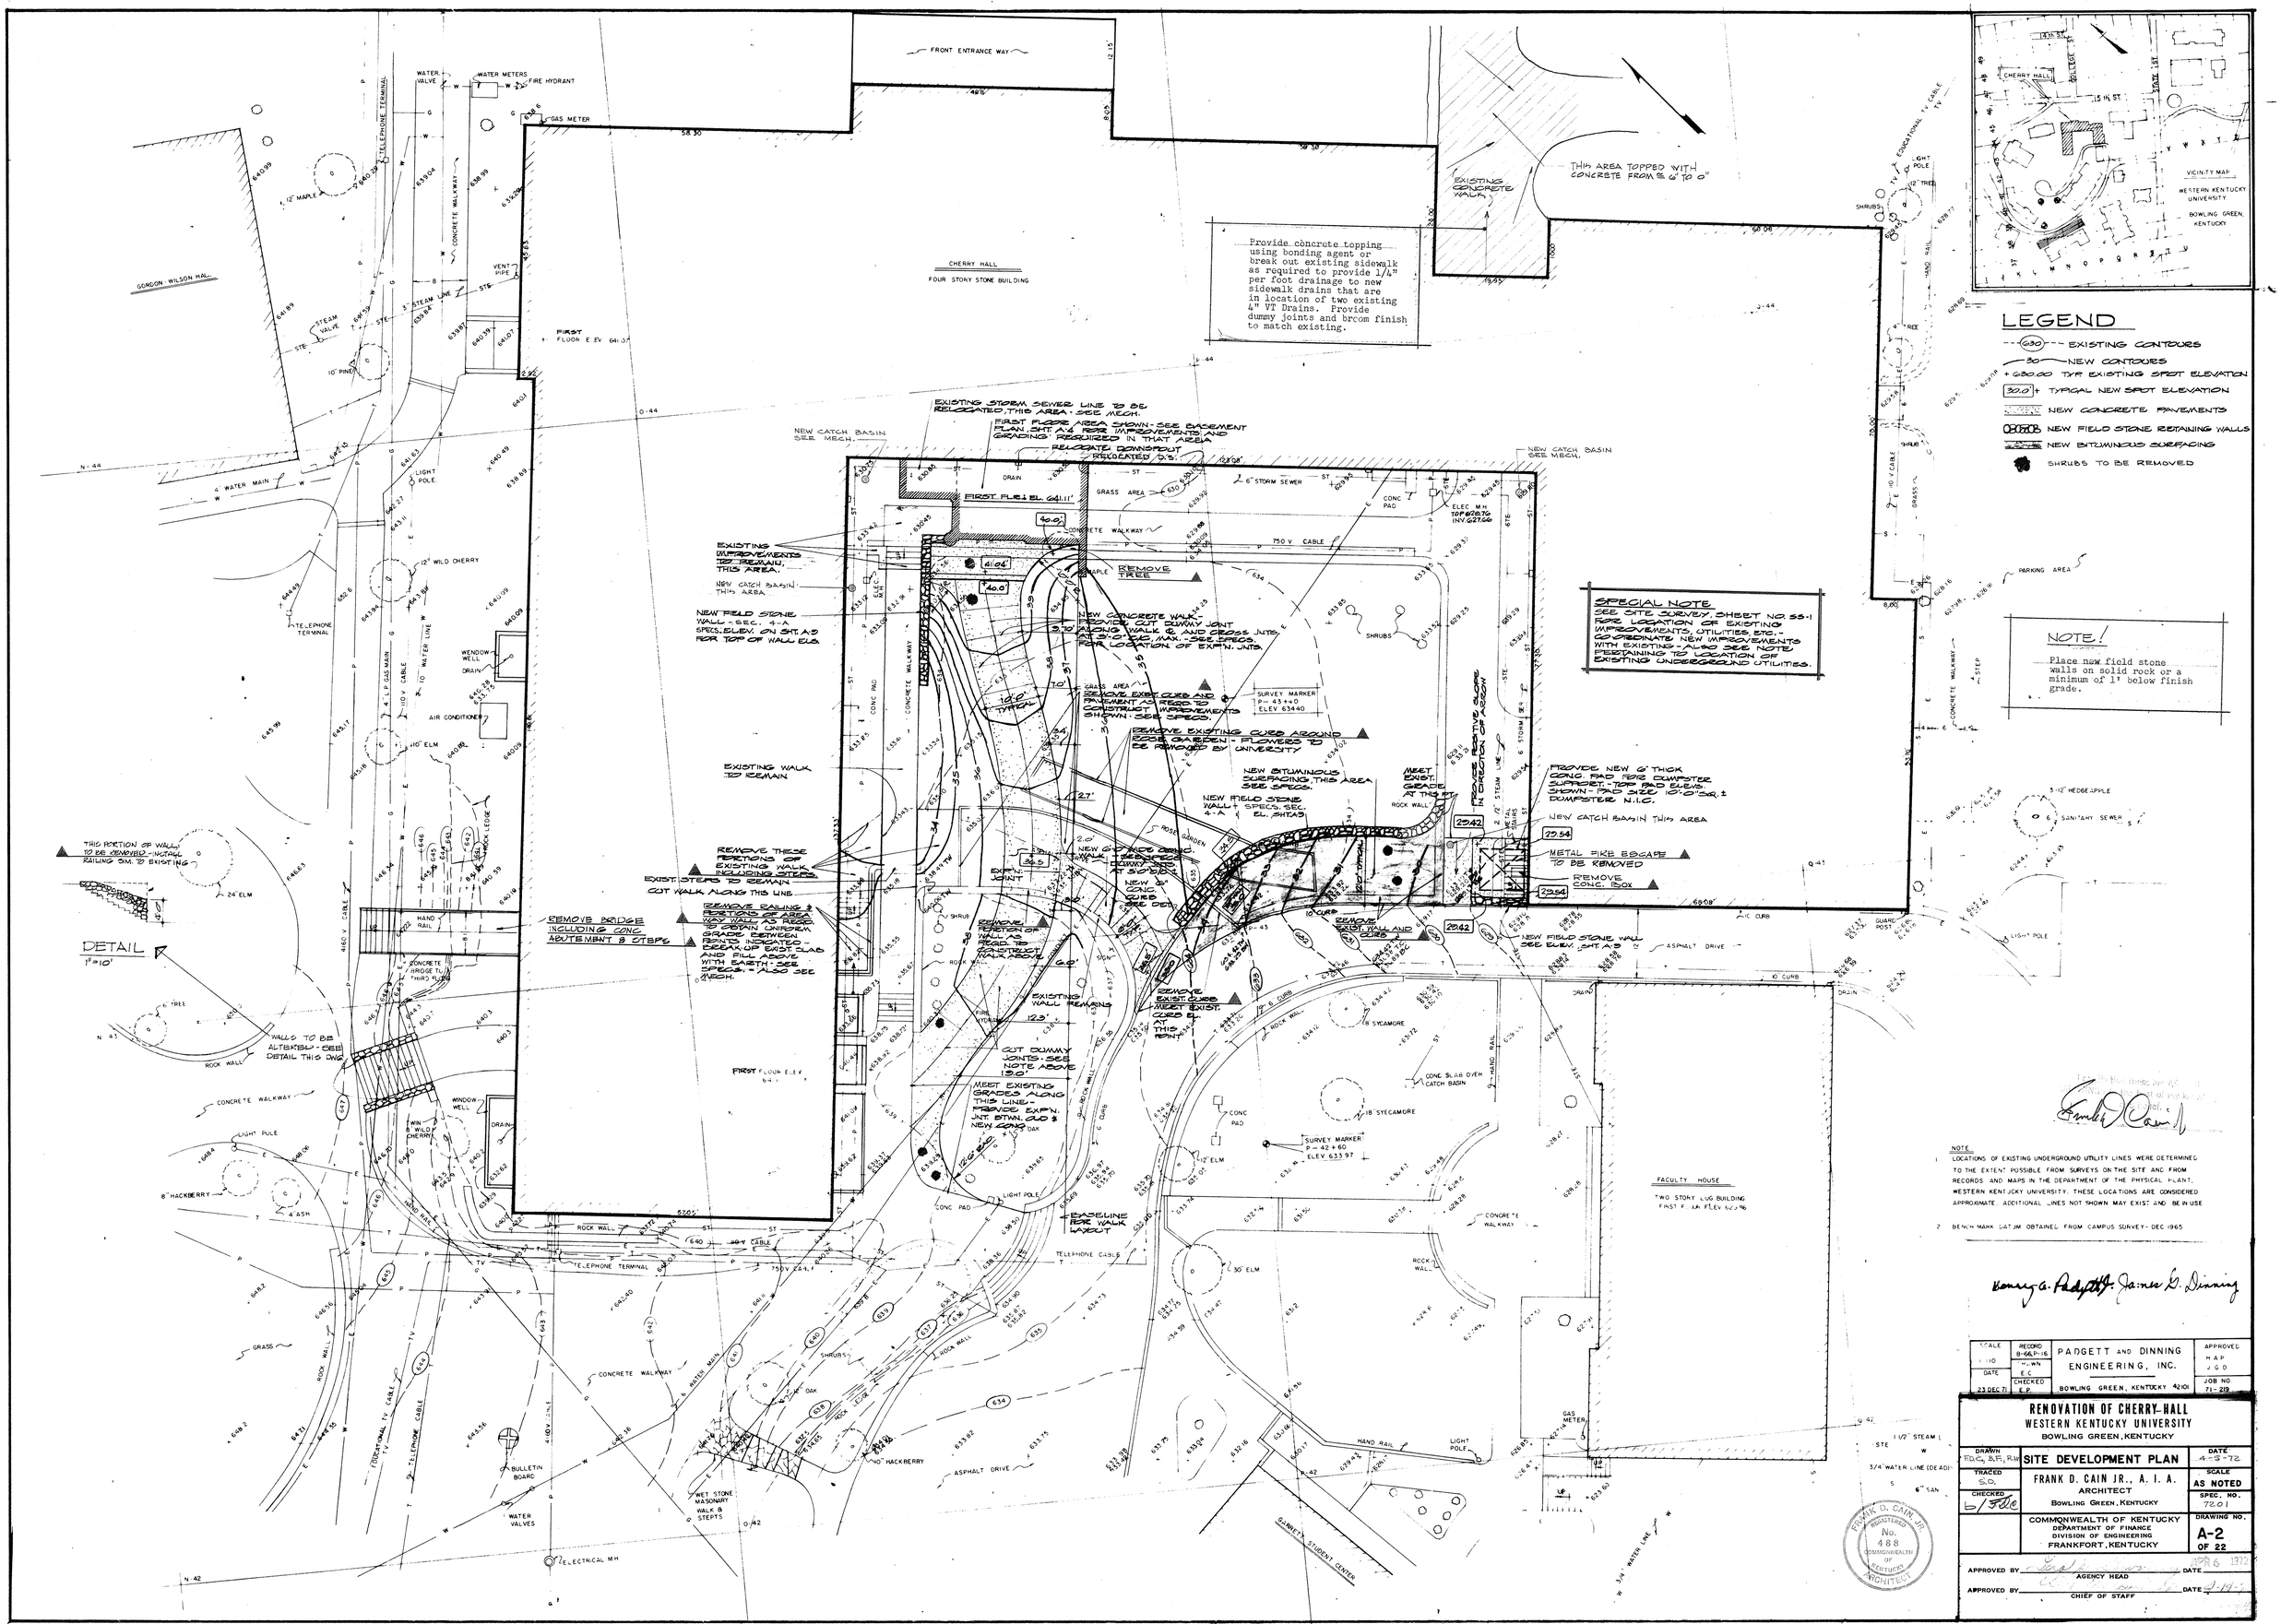

NOTE

1 LOCATIONS OF EXISTING UNDERGROUND UTILITY LINES WERE DETERMINED TO THE EXTENT POSSIBLE FROM SURVEYS ON THE SITE AND FROM RECORDS AND MAPS IN THE DEPARTMENT OF THE PHYSICAL PLANT, WESTERN KENTUCKY UNIVERSITY. THESE LOCATIONS ARE CONSIDERED APPROXIMATE. ADDITIONAL LINES NOT SHOWN MAY EXIST AND BE IN USE.

2 BENCH MARK DATUM OBTAINED FROM CAMPUS SURVEY - DEC 1965

Frank D. Cain Jr.

Bonnie A. Padgett Jr. James D. Dinning

SCALE 1"=10'	RECORD D-64,P-16	PADGETT AND DINNING ENGINEERING, INC.	APPROVED H.A.P. J.G.D.
DATE 23 DEC 71	DRAWN E.C.		
	CHECKED E.P.	BOWLING GREEN, KENTUCKY 42101	JOB NO. 71-219

RENOVATION OF CHERRY HALL
WESTERN KENTUCKY UNIVERSITY
BOWLING GREEN, KENTUCKY

DRAWN RDC, B.F., R.H.	**SITE DEVELOPMENT PLAN**		DATE 4-3-72
TRACED S.S.	FRANK D. CAIN JR., A. I. A. ARCHITECT BOWLING GREEN, KENTUCKY		SCALE AS NOTED
CHECKED b/sde			SPEC. NO. 72.01
	COMMONWEALTH OF KENTUCKY DEPARTMENT OF FINANCE DIVISION OF ENGINEERING FRANKFORT, KENTUCKY		DRAWING NO. A-2 OF 22

APPROVED BY _____ DATE _____
AGENCY HEAD

APPROVED BY _____ DATE _____
CHIEF OF STAFF

FRANK D. CAIN JR. REGISTERED No. 488 COMMONWEALTH OF KENTUCKY ARCHITECT

R-2346

EXISTING FLOOR PLANS

NOTE:
SEE DRAWING A-22 FOR DETAILS OF EXISTING BUILDING

EXISTING ROOM FINISH NOTE BASEMENT

Classrooms, Laboratories, Book Store, and Post Office: Plaster Walls and Ceiling, Oak Trim, Chair Rail and Stools, Concrete Floor and Base.

Offices: Plaster Walls and Ceiling, Oak Trim and Stools, Concrete Floor and Base.

Ante Rooms: Plaster walls and ceiling, Oak Trim and Chair Rail, Concrete Floor and Base.

Closets, Prep. Rooms, Storage Rooms, Meter Rooms, Photostat Room, Dark Room, Animal Room, Acid Storage Room, Mechanical Equipment Room, Janitor's Room and Janitor's Office: Plaster walls and ceiling, Yellow Pine Trim, Concrete Floor and Base.

Corridors: Plaster walls and ceiling, Oak Trim and Chair Rail: 3' 2" High Keene Cement Wainscot, Concrete Floor and Base.

Toilet Rooms and Toilet Vestibules: Plaster Walls and Ceiling, Poplar Trim, Marble Stools, 6' 0" high Keene Cement Wainscot, Concrete Floor and Base.

Passage: Plaster Ceiling, Stucco Walls, Oak Trim, Concrete floor and base.

FIRST, SECOND, AND THIRD FLOORS

Classrooms and Laboratories: Plaster walls and ceilings, Oak Trim, Base, Chair Rail, and Stools, Maple Floor.

Offices: Plaster Walls and Ceiling, Oak Trim, Base and Stools, Maple Floors.

Ante Rooms; Rest Rooms; Work Space: Plaster Walls and Ceiling, Oak Trim, Base and Chair Rail, Maple Floors.

Closets and Janitor Rooms: Plaster Walls and Ceilings, Yellow Pine Trim and Base, Concrete Floor.

Corridors: Plaster Walls and Ceilings, Marble Base, Plinths, Wainscot and Wainscot Cap -- Oak Trim, Composition Asphalt Tile Floor.

Toilet Rooms & Toilet Vestibules: Plaster Walls and Ceilings, Poplar Trim, Marble Stool-6' 0" high Keene Cement Wainscot, Terrazzo Floor and Base.

Pipe Shafts: Pipe Shafts to have iron gratings at each floor level.

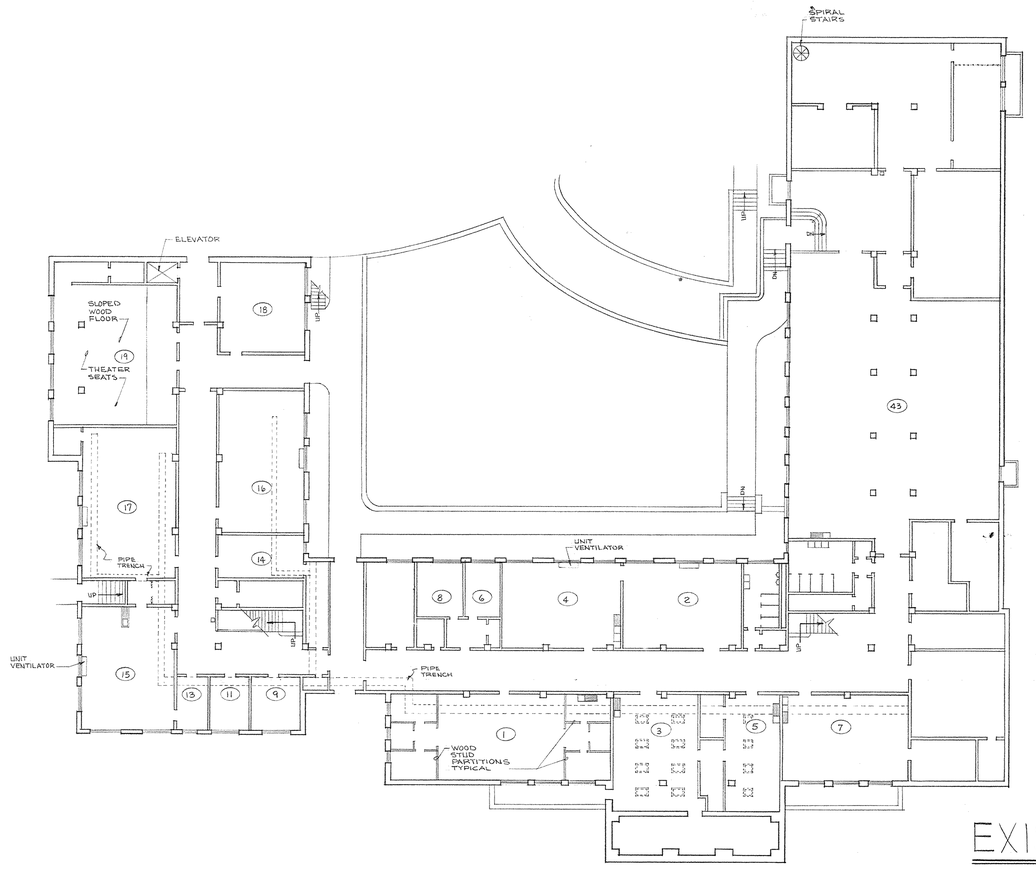

BASEMENT FLOOR PLAN
SCALE: 1/16" = 1'-0"

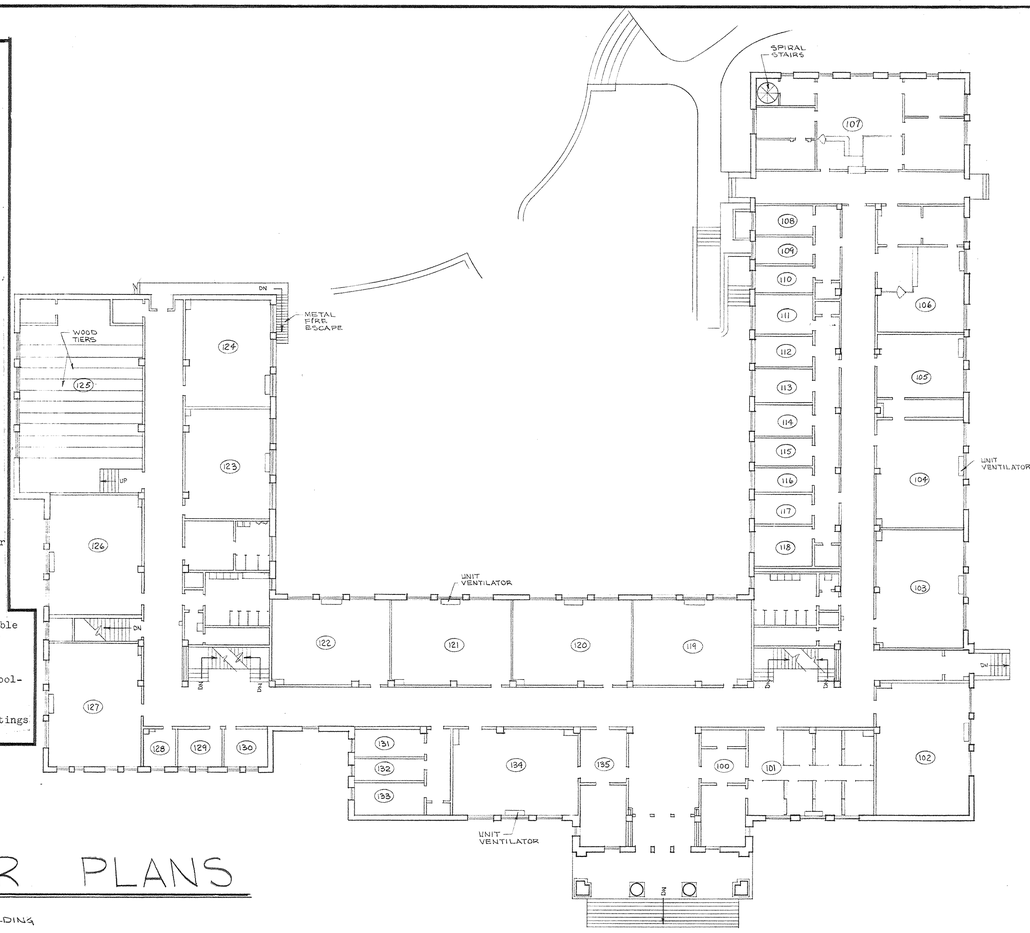

FIRST FLOOR PLAN
SCALE: 1/16" = 1'-0"

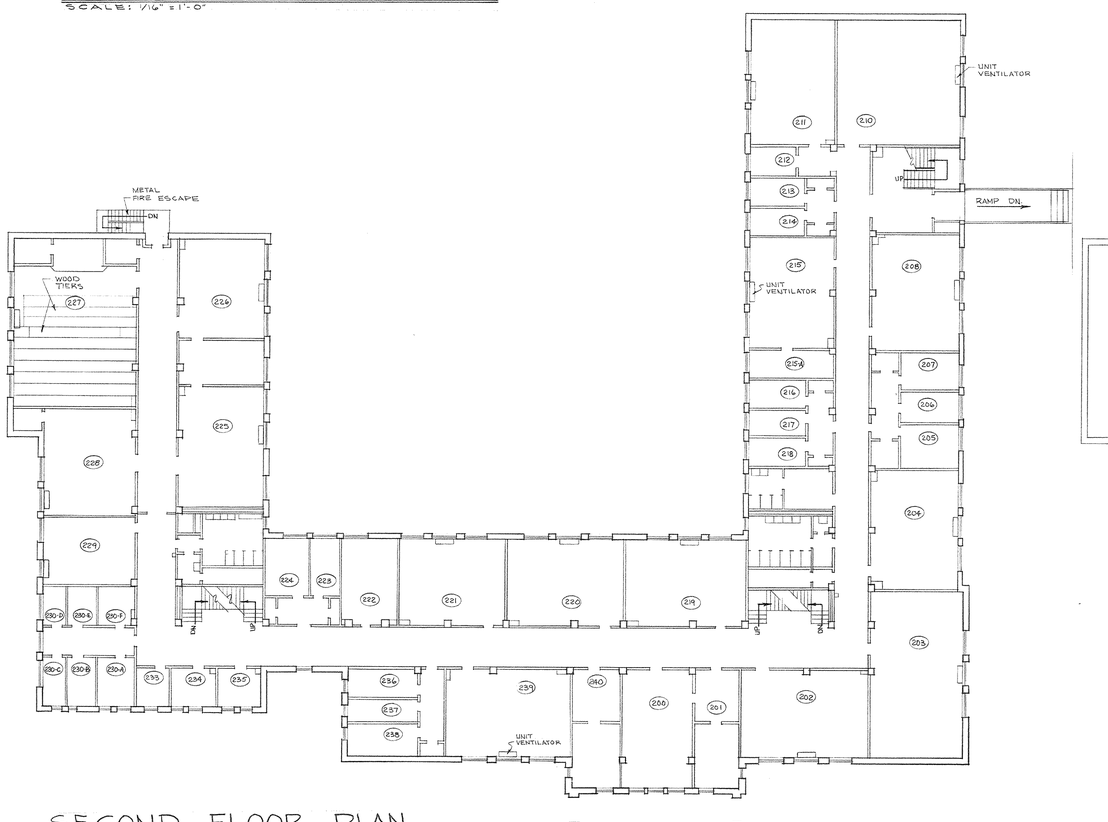

SECOND FLOOR PLAN
SCALE: 1/16" = 1'-0"

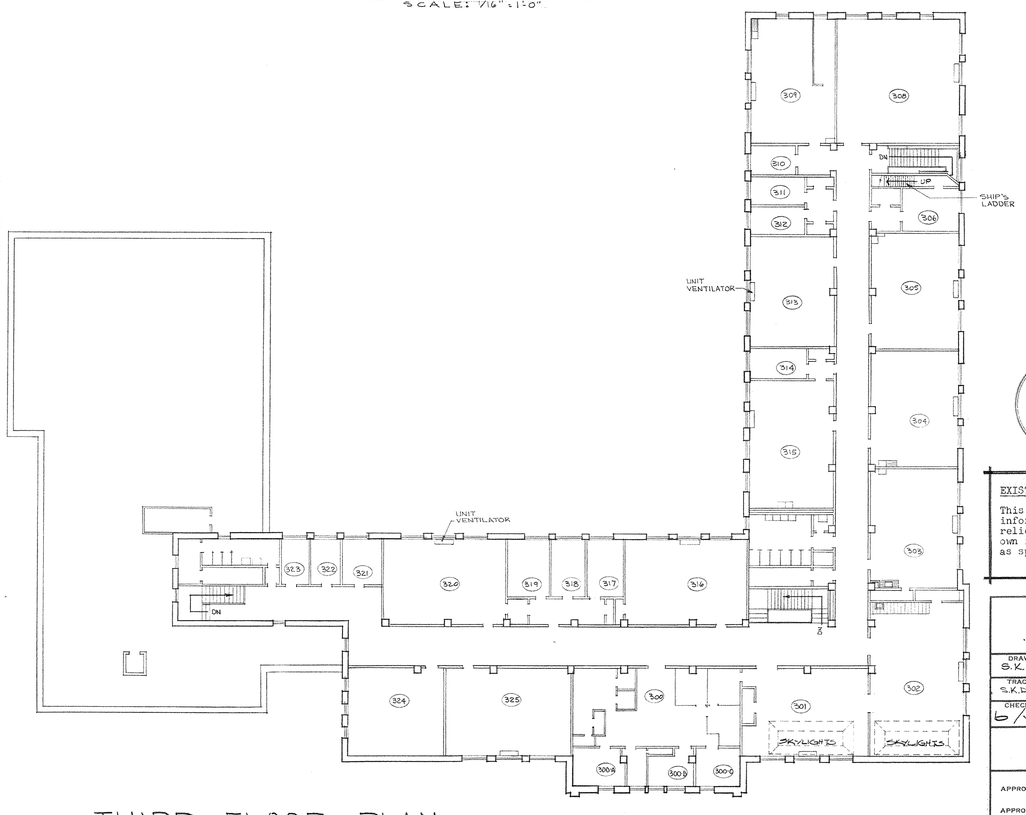

THIRD FLOOR PLAN
SCALE: 1/16" = 1'-0"

FRANK D. CAIN JR. REGISTERED No. 488 COMMONWEALTH OF KENTUCKY ARCHITECT

I certify that these are AS BUILT DRAWINGS to the best of my knowledge and belief.

EXISTING DRAWINGS:

This sheet has been prepared for the general information of the Contractors. It does not relieve them of the requirement to make their own investigation of the existing building, as specified in the Contract Documents.

RENOVATION OF CHERRY HALL
WESTERN KENTUCKY UNIVERSITY
BOWLING GREEN, KENTUCKY

DRAWN S.K.D.	EXISTING FLOOR PLANS	DATE 4-5-72
TRACED S.K.D.	FRANK D. CAIN JR., A. I. A. ARCHITECT BOWLING GREEN, KENTUCKY	SCALE AS NOTED
CHECKED 6/1972		SPEC. NO. 7201
	COMMONWEALTH OF KENTUCKY DEPARTMENT OF FINANCE DIVISION OF ENGINEERING FRANKFORT, KENTUCKY	DRAWING NO. A-3 OF 22

APPROVED BY _____ DATE 1972
AGENCY HEAD
APPROVED BY _____ DATE 4-14-72
CHIEF OF STAFF

K-2347

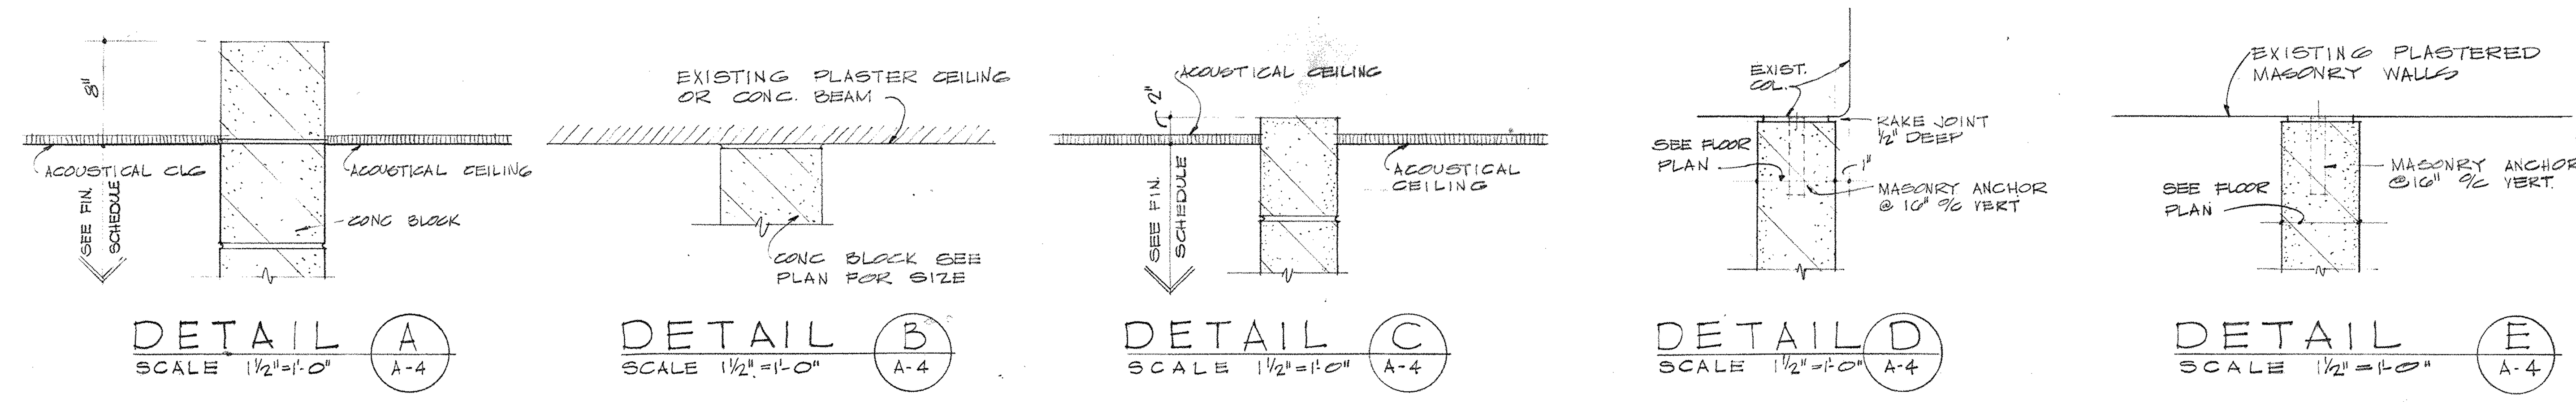

NOTE: Contractor refer to Mechanical and Electrical Drawings and Specifications for location and size of louvers, etc. that are to be furnished by the Mechanical Contractor, for installation under the Architectural Specifications and Architectural Drawings.

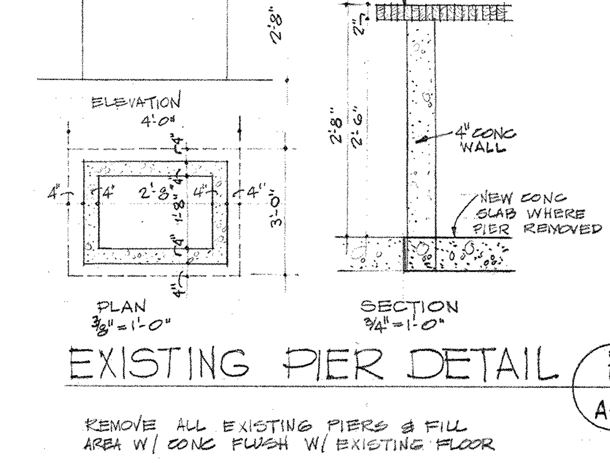

NOTE: The following symbols indicate the disposition and handling of various items in the Building at the time Working Drawings were prepared. These items shown do not relieve the Contractor of his responsibility to handle any item not shown in accordance with the Contract Drawings, Specifications, and Documents.

- ● To remain and be protected by Contractor. Refinish as indicated and/or specified.
- ◆ To be removed, protected, and delivered to Owner at Site.
- ■ To be removed by Owner prior to construction.
- ▲ To be removed from Site by Contractor.
- ⬢ To be relocated in building by Contractor. Refinish as indicated and/or specified.

NOTE: Carry all concrete block walls that enclose Stairs 1, 2, 4, and 5 to underside of plaster or structural slab, to seal off Stair Enclosure. All corridor partitions and smoke door partitions go to underside of plaster of structural slab, unless otherwise noted.

NOTE: Turn existing trench covers over and install new tile over same. See Drawing A-3 for trench locations.

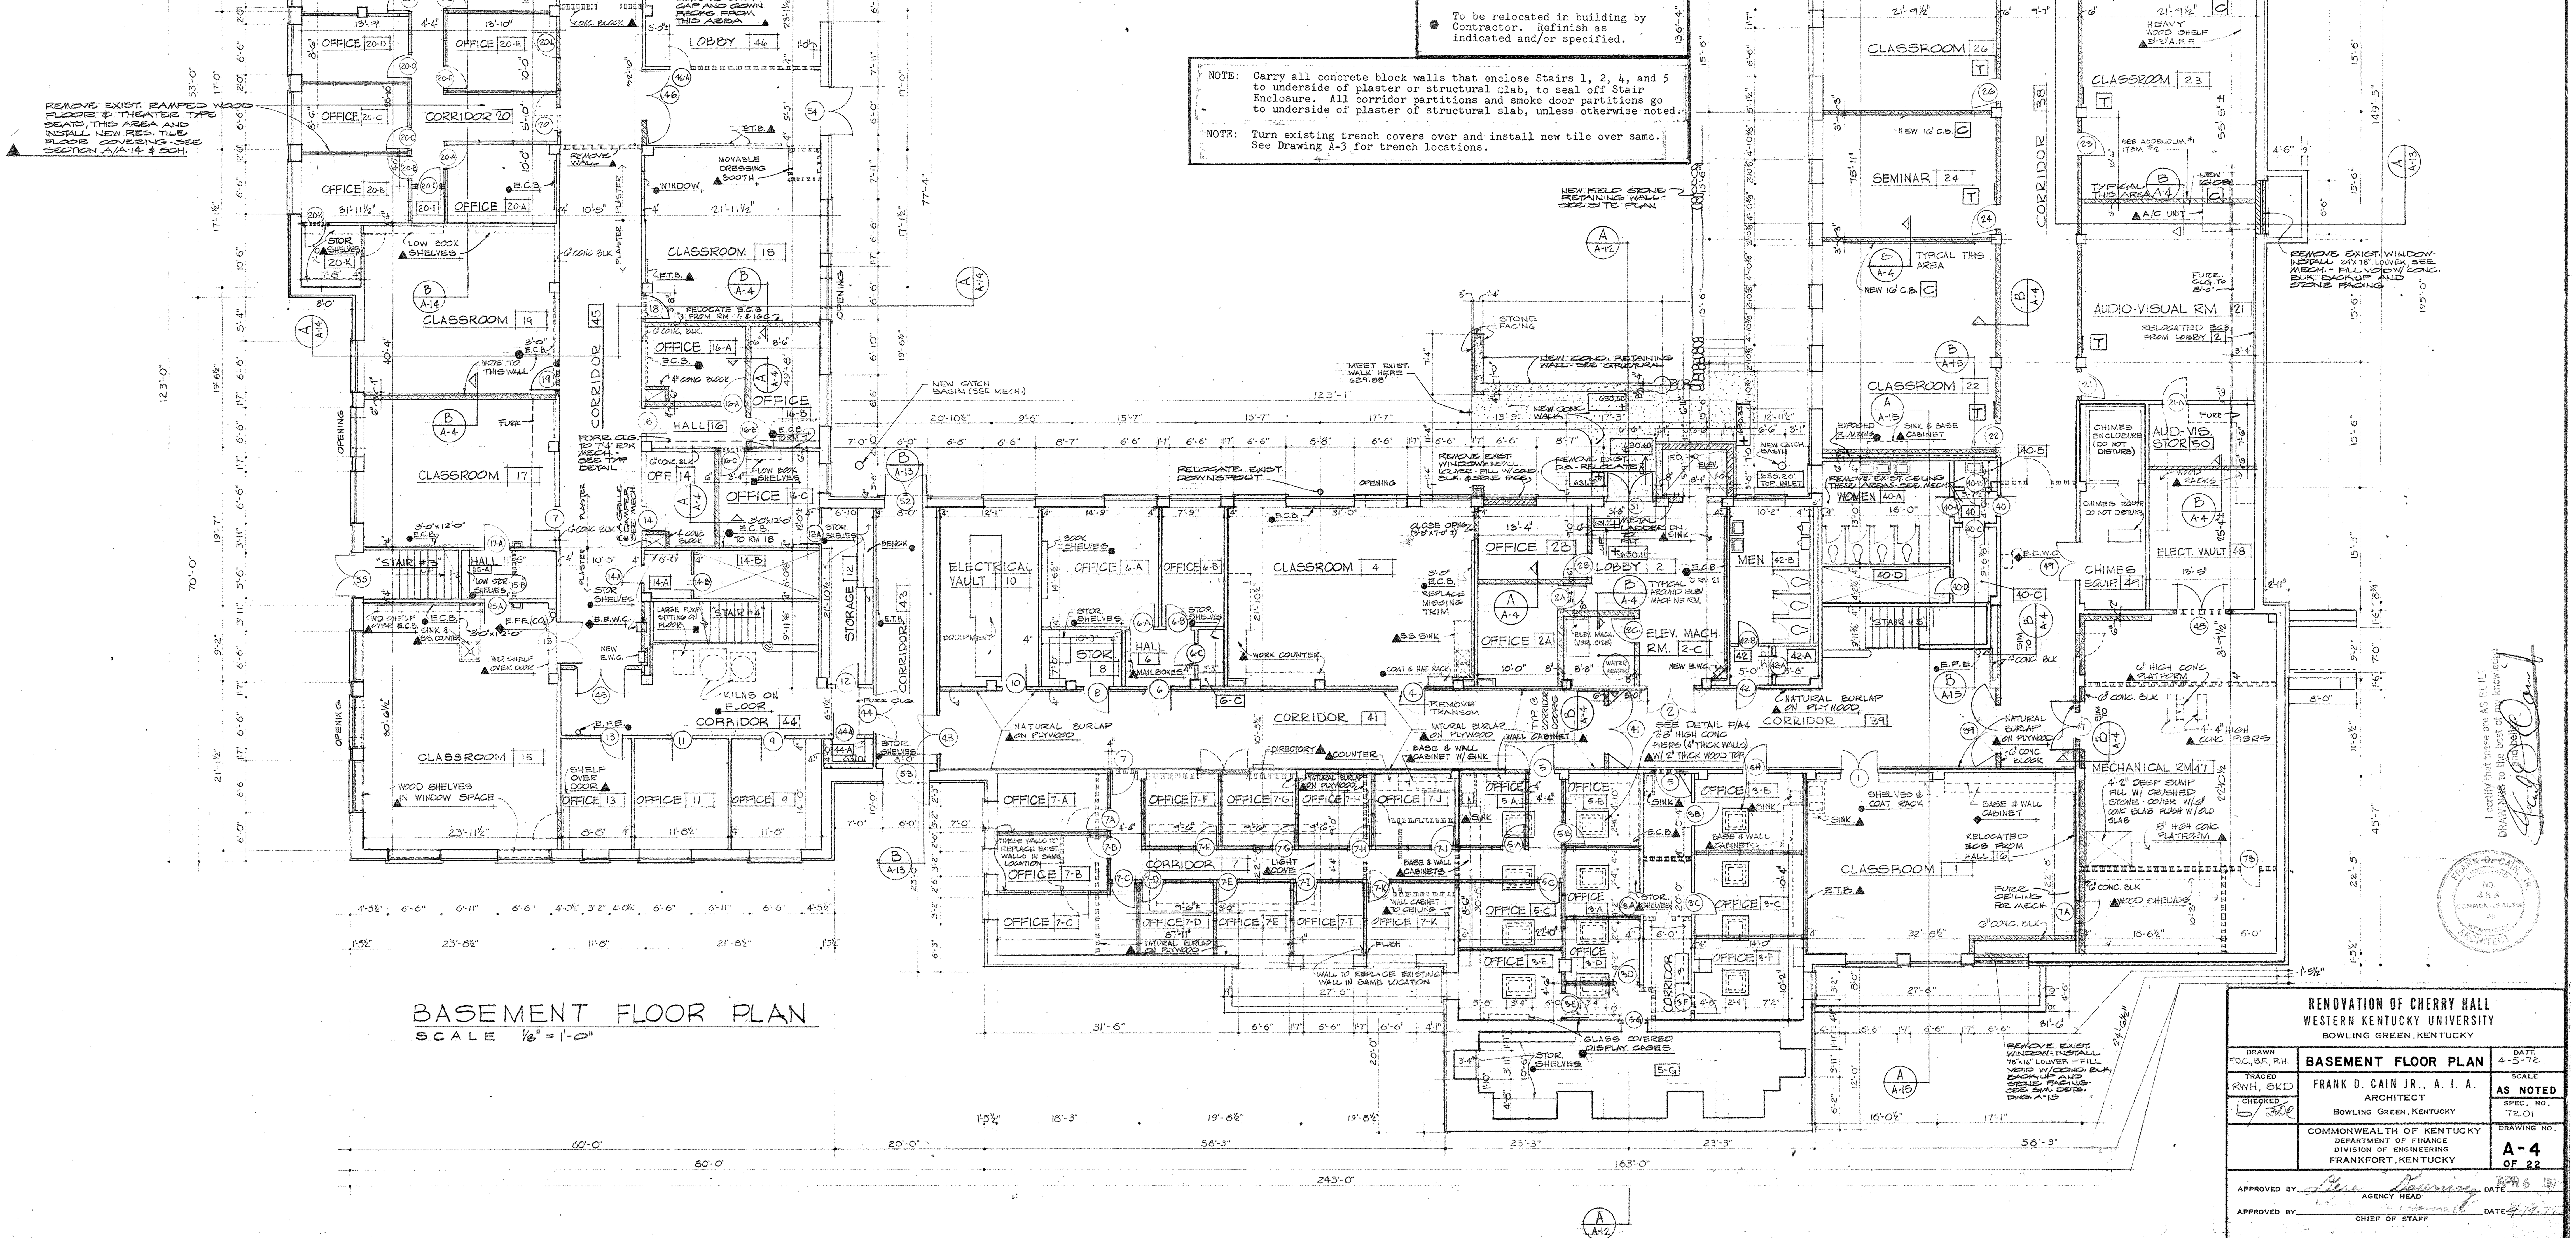

BASEMENT FLOOR PLAN
SCALE 1/8" = 1'-0"

I certify that these are AS BUILT DRAWINGS to the best of my knowledge and belief

FRANK D. CAIN, JR. REGISTERED No. 488 COMMONWEALTH OF KENTUCKY ARCHITECT

RENOVATION OF CHERRY HALL
WESTERN KENTUCKY UNIVERSITY
BOWLING GREEN, KENTUCKY

DRAWN F.D.C., B.F., R.H.	BASEMENT FLOOR PLAN	DATE 4-5-72
TRACED RWH, SKD	FRANK D. CAIN JR., A. I. A. ARCHITECT BOWLING GREEN, KENTUCKY	SCALE AS NOTED
CHECKED		SPEC. NO. 7201
	COMMONWEALTH OF KENTUCKY DEPARTMENT OF FINANCE DIVISION OF ENGINEERING FRANKFORT, KENTUCKY	DRAWING NO. A-4 OF 22

APPROVED BY ____ AGENCY HEAD DATE APR 6 197_

APPROVED BY ____ CHIEF OF STAFF DATE 4-19-72

R-2348

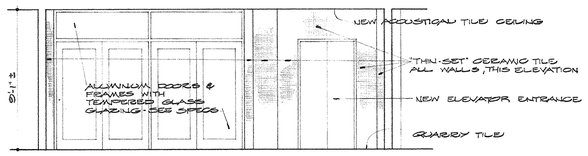

ELEVATION A ROOM 147
SCALE 1/4" = 1'-0"

NOTE: The following symbols indicate the disposition and handling of various items in the Building at the time Working Drawings were prepared. These items shown do not relieve the Contractor of his responsibility to handle any item not shown in accordance with the Contract Drawings, Specifications, and Documents.

- ● To remain and be protected by Contractor. Refinish as indicated and/or specified.
- ◆ To be removed, protected, and delivered to Owner at Site.
- ■ To be removed by Owner prior to construction.
- ▲ To be removed from Site by Contractor.
- ⬢ To be relocated in building by Contractor. Refinish as indicated and/or specified.

NOTE: Contractor refer to Mechanical and Electrical Drawings and Specifications for location and size of louvers, etc. that are to be furnished by the Mechanical Contractor, for installation under the Architectural Specifications and Architectural Drawings.

NOTE: Carry all concrete block walls that enclose Stairs 1, 2, 4, and 5 to underside of plaster or structural slab, to seal off Stair Enclosure. All corridor partitions and smoke door partitions go to underside of plaster or structural slab, unless otherwise noted.

Provide new wood floor and 24" X 24" removable Access Door. Frame to leave room to service Units located under Stage.

NOTE! SEE SITE IMPROVEMENT PLAN, SHEET A-2 FOR CONTINUATION OF SITE IMPROVEMENTS, THIS AREA

EXISTING CONDITIONS

SEE SITE IMPROVEMENT PLAN - SHT. A-2

NOTE:
1. EXISTING WOOD FLOOR TO BE CUT & REMOVED TO ALLOW NEW MASONRY WALL TO REST ON CONCRETE SUB-FLOOR

CABINET OVER URINALS AT ROOM 123B
SCALE 1/4" = 1'-0"

FIRST FLOOR PLAN
SCALE 1/8" = 1'-0"

I certify that these are AS BUILT DRAWINGS to the best of my knowledge.
Frank D. Cain Jr.

RENOVATION OF CHERRY HALL WESTERN KENTUCKY UNIVERSITY BOWLING GREEN, KENTUCKY		
DRAWN F.D.C., R.H., B.F.	FIRST FLOOR PLAN	DATE 4-8-72
TRACED F.H., J.D.	FRANK D. CAIN JR., A. I. A. ARCHITECT BOWLING GREEN, KENTUCKY	SCALE AS NOTED
CHECKED BY		SPEC. NO. 72-01
	COMMONWEALTH OF KENTUCKY DEPARTMENT OF FINANCE DIVISION OF ENGINEERING FRANKFORT, KENTUCKY	DRAWING NO. A-5 OF 22
APPROVED BY [signature] AGENCY HEAD		DATE APR 6 1972
APPROVED BY [signature] CHIEF OF STAFF		DATE 4/4/72

R-2349

NOTE: Carry all concrete block walls that enclose Stairs 1, 2, 4, and 5 to underside of plaster or Structural Slab, to seal off Stair Enclosure. All corridor partitions and smoke door partitions go to underside of plaster or structural slab, unless otherwise noted.

NOTE: The following symbols indicate the disposition and handling of various items in the Building at the time Working Drawings were prepared. These items shown do not relieve the Contractor of his responsibility to handle any item not shown in accordance with the Contract Drawings, Specifications, and Documents.

- ● To remain and be protected by Contractor. Refinish as indicated and/or specified.
- ◆ To be removed, protected, and delivered to the Owner at the Site.
- ■ To be removed by Owner prior to construction.
- ▲ To be removed from Site by Contractor.
- ⬢ To be relocated in building by Contractor. Refinish as indicated and/or specified.

NOTE: Contractor refer to Mechanical and Electrical Drawings and Specifications for location and size of louvers, etc. that are to be furnished by the Mechanical Contractor, for installation under the Architectural Specifications and Architectural Drawings.

REMOVE EXISTING CEILING ABOVE CORRIDOR 251 BETWEEN THESE LINES - SEE MECH. DWGS.

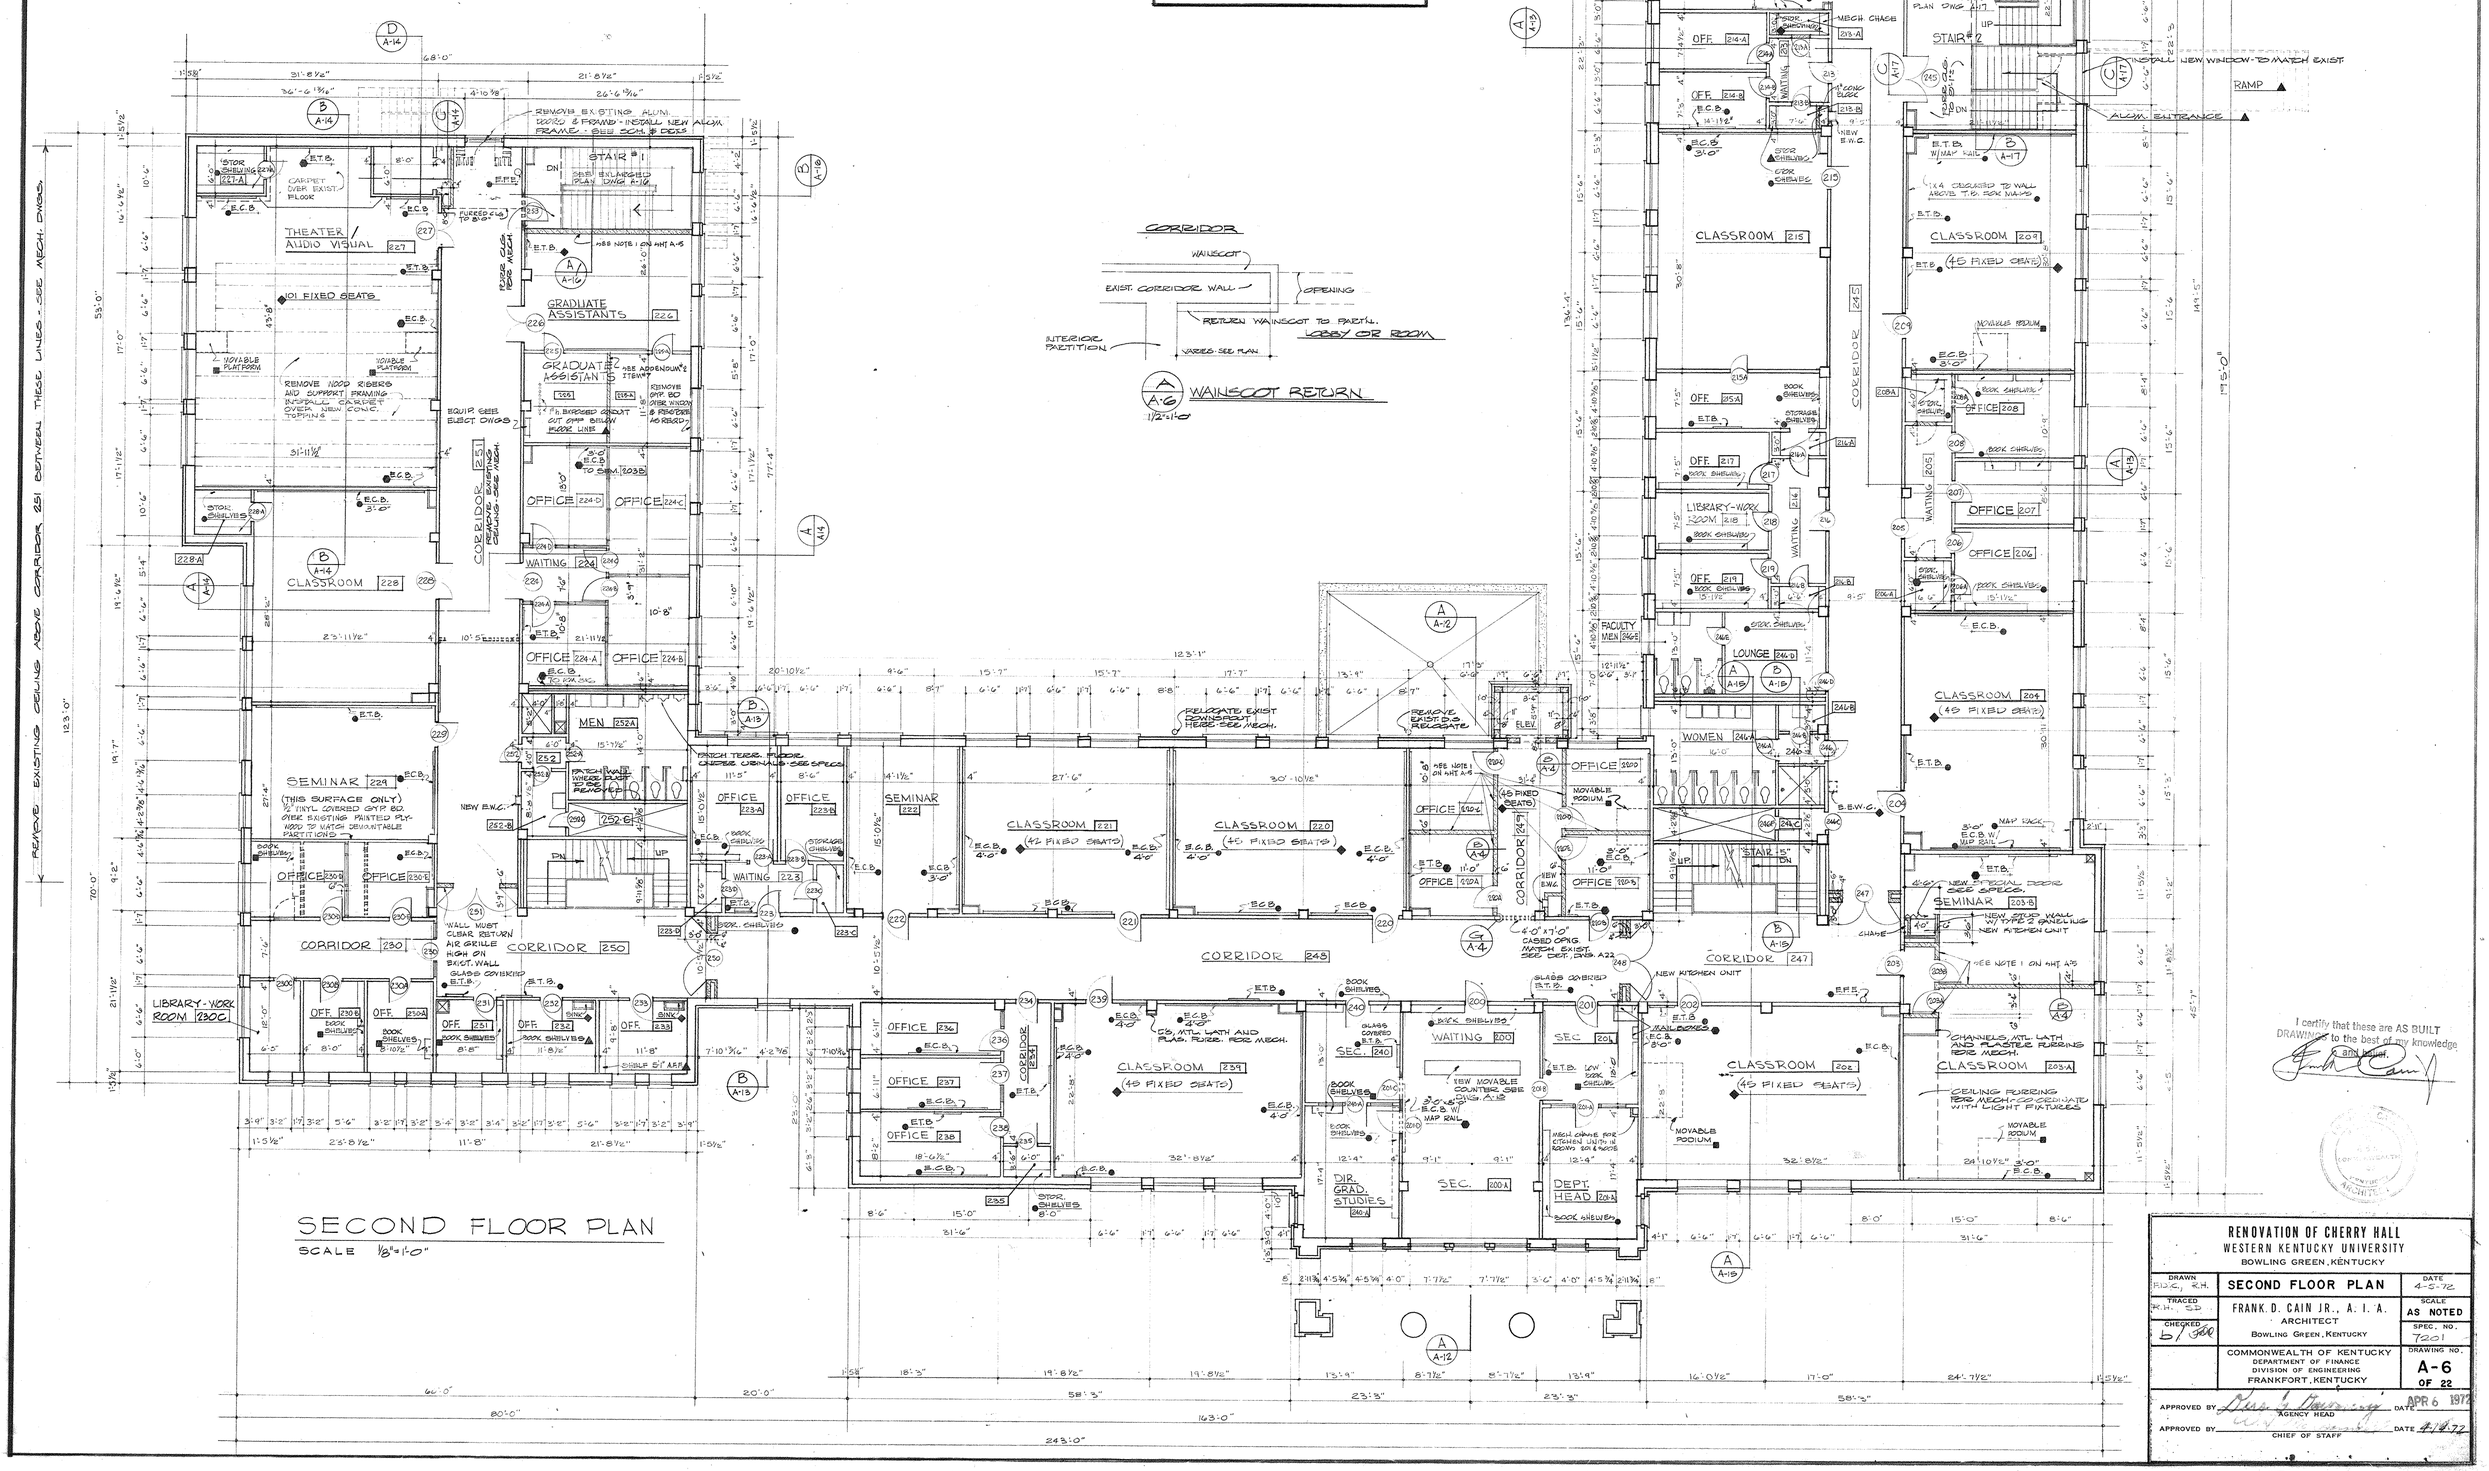

I certify that these are AS BUILT DRAWINGS to the best of my knowledge and belief.

	RENOVATION OF CHERRY HALL WESTERN KENTUCKY UNIVERSITY BOWLING GREEN, KENTUCKY	
DRAWN RDC, RH.	SECOND FLOOR PLAN	DATE 4-5-72
TRACED RH, SD	FRANK. D. CAIN JR., A. I. A. ARCHITECT Bowling Green, Kentucky	SCALE AS NOTED
CHECKED FDC		SPEC. NO. 7201
	COMMONWEALTH OF KENTUCKY DEPARTMENT OF FINANCE DIVISION OF ENGINEERING FRANKFORT, KENTUCKY	DRAWING NO. A-6 OF 22
APPROVED BY	AGENCY HEAD	DATE APR 6 1972
APPROVED BY	CHIEF OF STAFF	DATE 4-18-72

K-2350

NOTE: Carry all concrete block walls that enclose Stairs 1, 2, 4, and 5 to underside of plaster or structural slab, to seal off Stair Enclosure. All corridor partitions and smoke door partitions go to underside of plaster of structural slab, unless otherwise noted.

NOTE: Contractor refer to Mechanical and Electrical Drawings and Specifications for location and size of louvers, etc, that are to be furnished by the Mechanical Contractor, for installation under the Architectural Specifications and Architectural Drawings.

NOTE: The following symbols indicate the disposition and handling of various items in the Building at the time Working Drawings were prepared. These items shown do not relieve the Contractor of his responsibility to handle any item not shown in accordance with the Contract Drawings, Specifications, and Documents:

- ● To remain and be protected by Contractor. Refinish as indicated and/or specified.
- ◆ To be removed, protected, and delivered to the Owner at the Site.
- ■ To be removed by Owner prior to construction.
- ▲ To be removed from Site by Contractor.
- ⬢ To be relocated in building by Contractor. Refinish as indicated and/or specified.

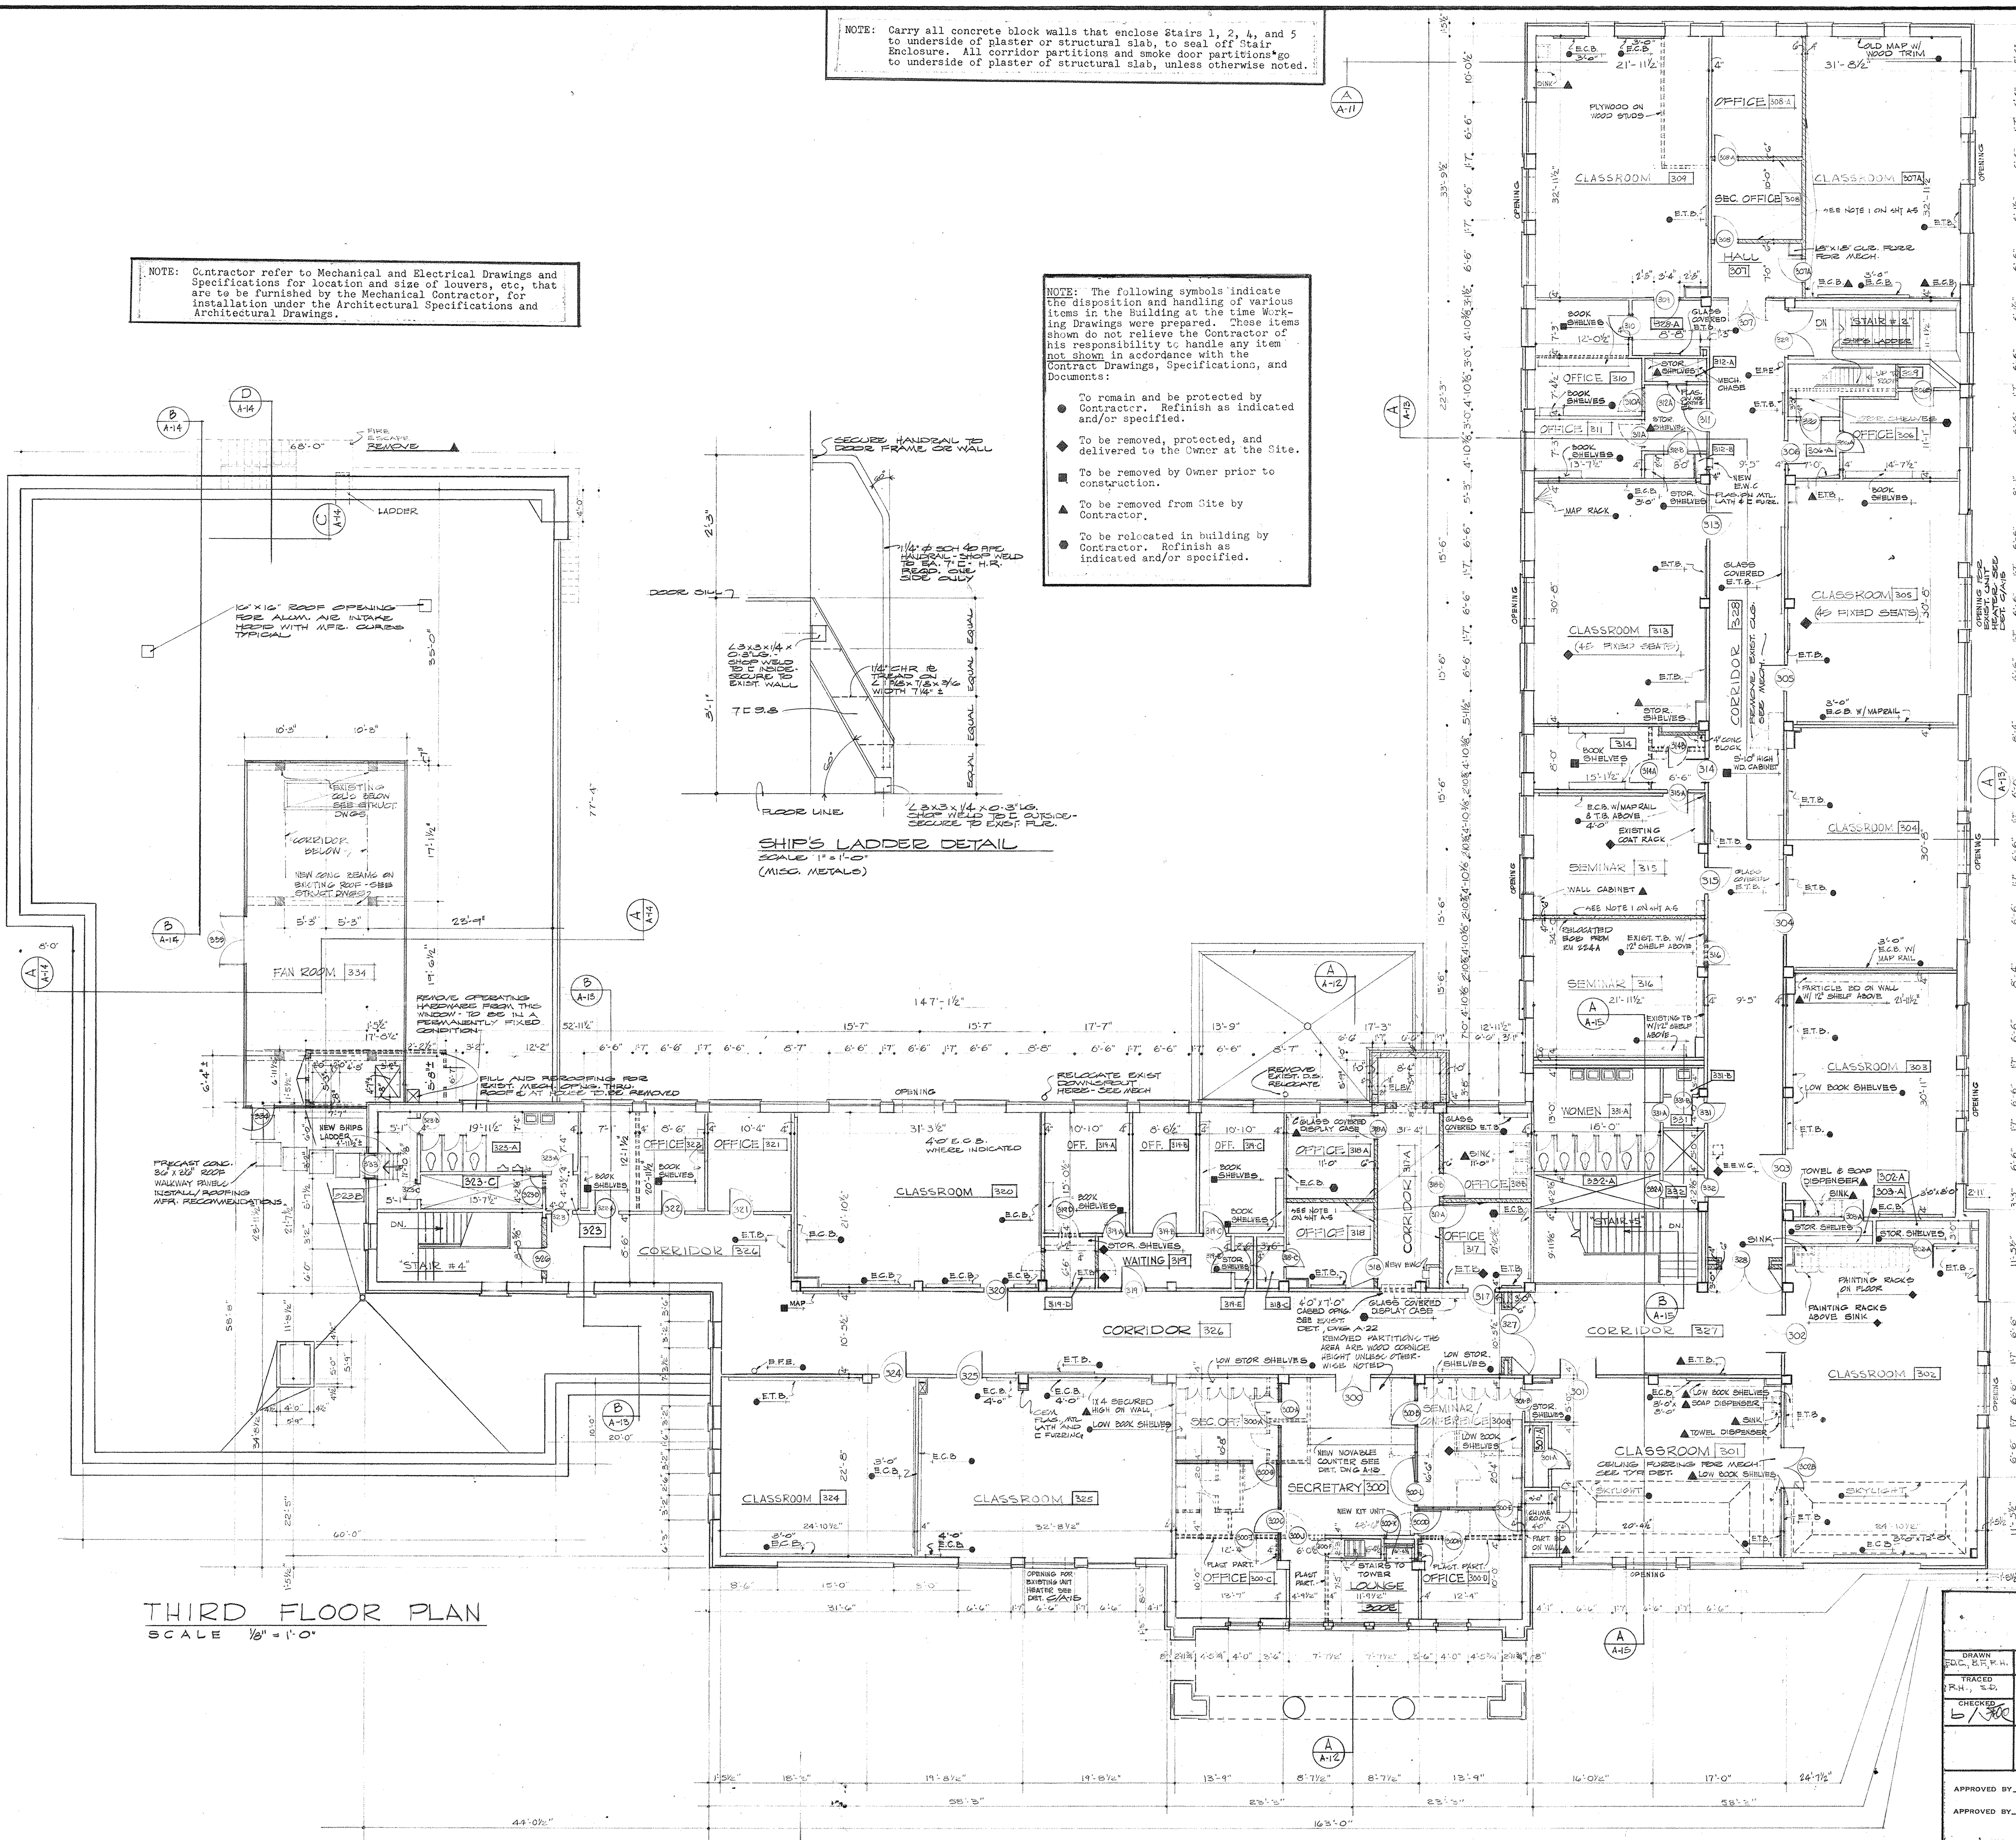

SHIP'S LADDER DETAIL
SCALE 1" = 1'-0"
(MISC. METALS)

THIRD FLOOR PLAN
SCALE 1/8" = 1'-0"

RENOVATION OF CHERRY HALL WESTERN KENTUCKY UNIVERSITY BOWLING GREEN, KENTUCKY		
DRAWN F.D.C., B.F., R.H.	THIRD FLOOR PLAN	DATE 4-5-72
TRACED R.H., S.D.	FRANK D. CAIN JR., A. I. A. ARCHITECT BOWLING GREEN, KENTUCKY	SCALE AS NOTED
CHECKED b/300		SPEC. NO. 7201
	COMMONWEALTH OF KENTUCKY DEPARTMENT OF FINANCE DIVISION OF ENGINEERING FRANKFORT, KENTUCKY	DRAWING NO. A-7 OF 22

APPROVED BY Jess G. Downing DATE APR 6 1972
AGENCY HEAD
APPROVED BY W. T. McDonald DATE 4-19-72
CHIEF OF STAFF

I certify that these are AS BUILT drawings to the best of my knowledge and belief. Frank D. Cain

FRANK D. CAIN, JR. REGISTERED NO. 488 COMMONWEALTH OF KENTUCKY ARCHITECT

R-2351

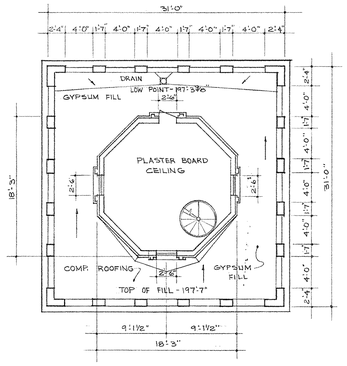

TOWER (EXISTING)
SCALE: 1/8" = 1'-0"

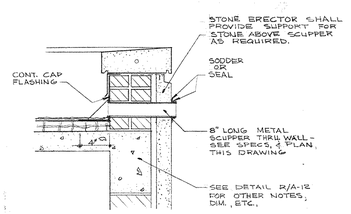

SCUPPER DETAIL AT ROOF OVER ELEVATOR
SCALE: 1"=1'-0"

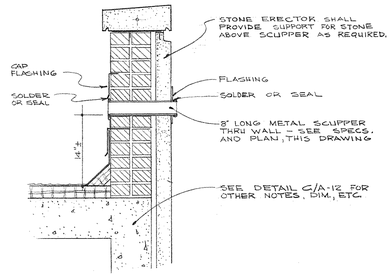

SCUPPER DETAIL AT ROOF OVER NEW ENTRY
SCALE: 1"=1'-0"

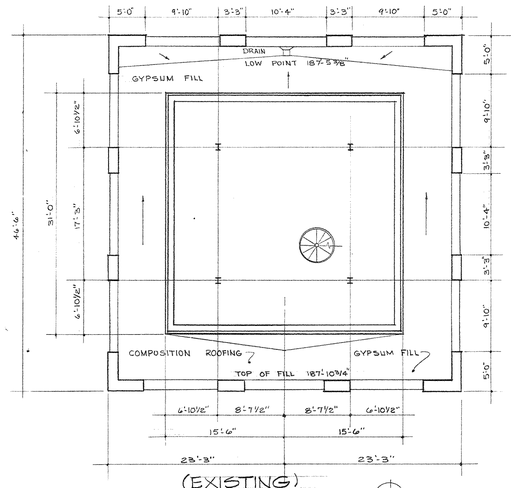

(EXISTING)
SQUARE DRUM
SCALE: 1/8" = 1'-0"

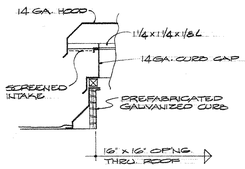

INTAKE HOOD DETAIL
DO NOT SCALE
(MISC. METAL)

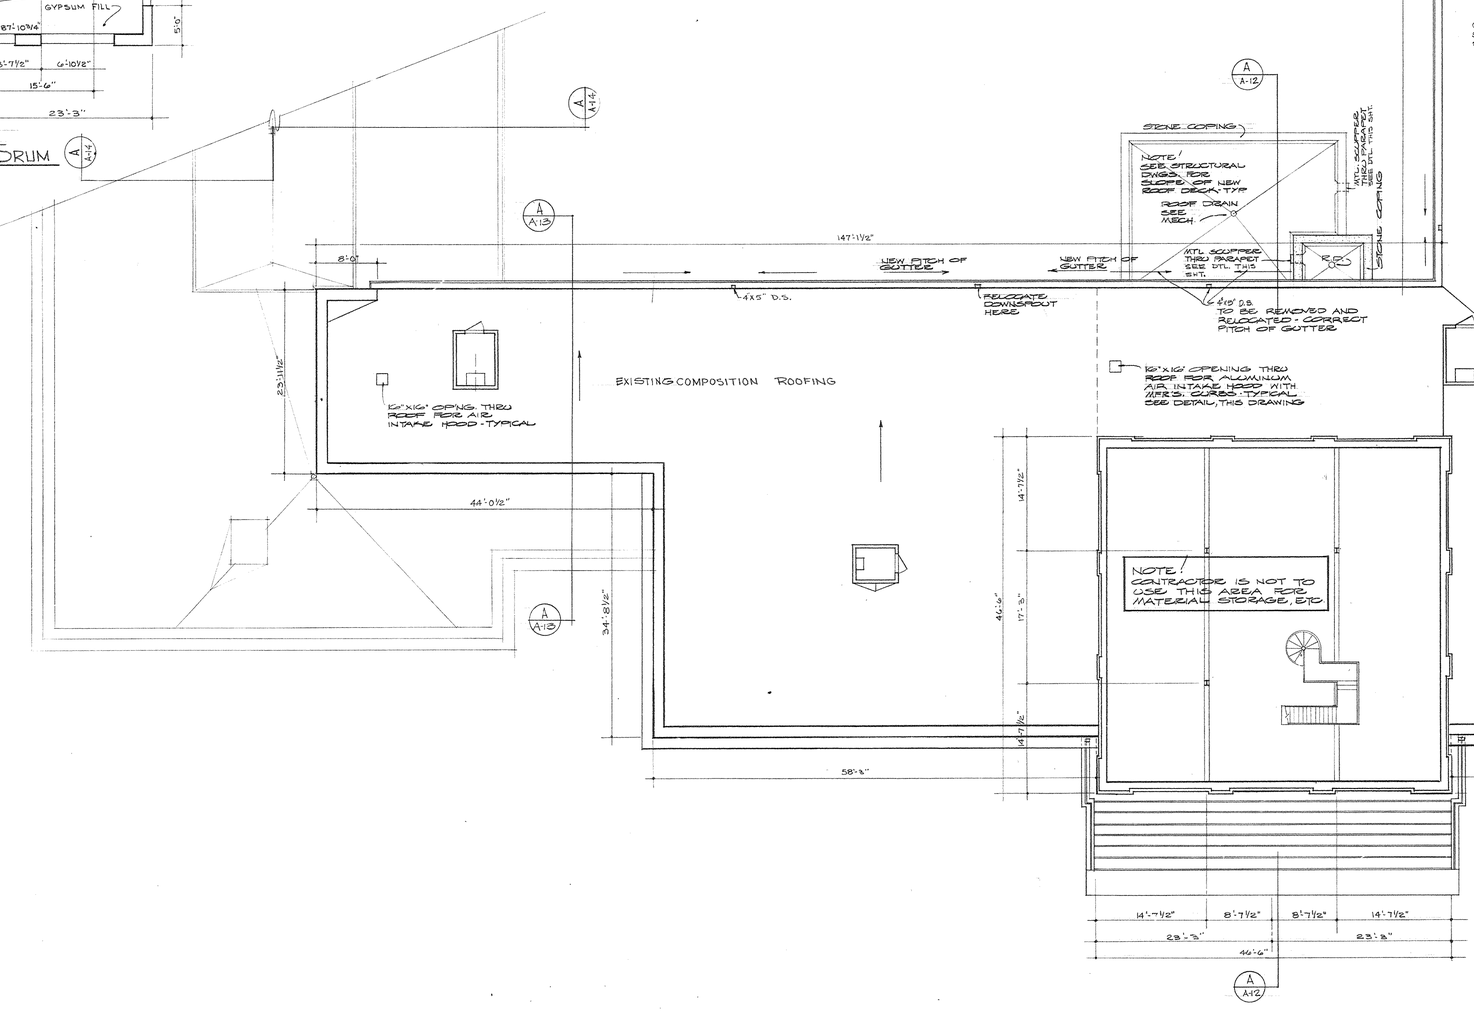

I certify that shown are AS BUILT drawings to the best of my knowledge

RENOVATION OF CHERRY HALL
WESTERN KENTUCKY UNIVERSITY
BOWLING GREEN, KENTUCKY

DRAWN E.D.C., B.F., R.H.	ROOF PLAN	DATE 4-5-72
TRACED R.H., S.D.	FRANK D. CAIN JR., A. I. A. ARCHITECT BOWLING GREEN, KENTUCKY	SCALE AS NOTED
CHECKED		SPEC. NO. 72.01
	COMMONWEALTH OF KENTUCKY DEPARTMENT OF FINANCE DIVISION OF ENGINEERING FRANKFORT, KENTUCKY	DRAWING NO. A-8 OF 22

APPROVED BY _____ DATE APR 6 1972
AGENCY HEAD
APPROVED BY _____ DATE 4-4-72
CHIEF OF STAFF

FRANK D. CAIN, JR. REGISTERED No. 438 COMMONWEALTH OF KENTUCKY ARCHITECT

R-2352

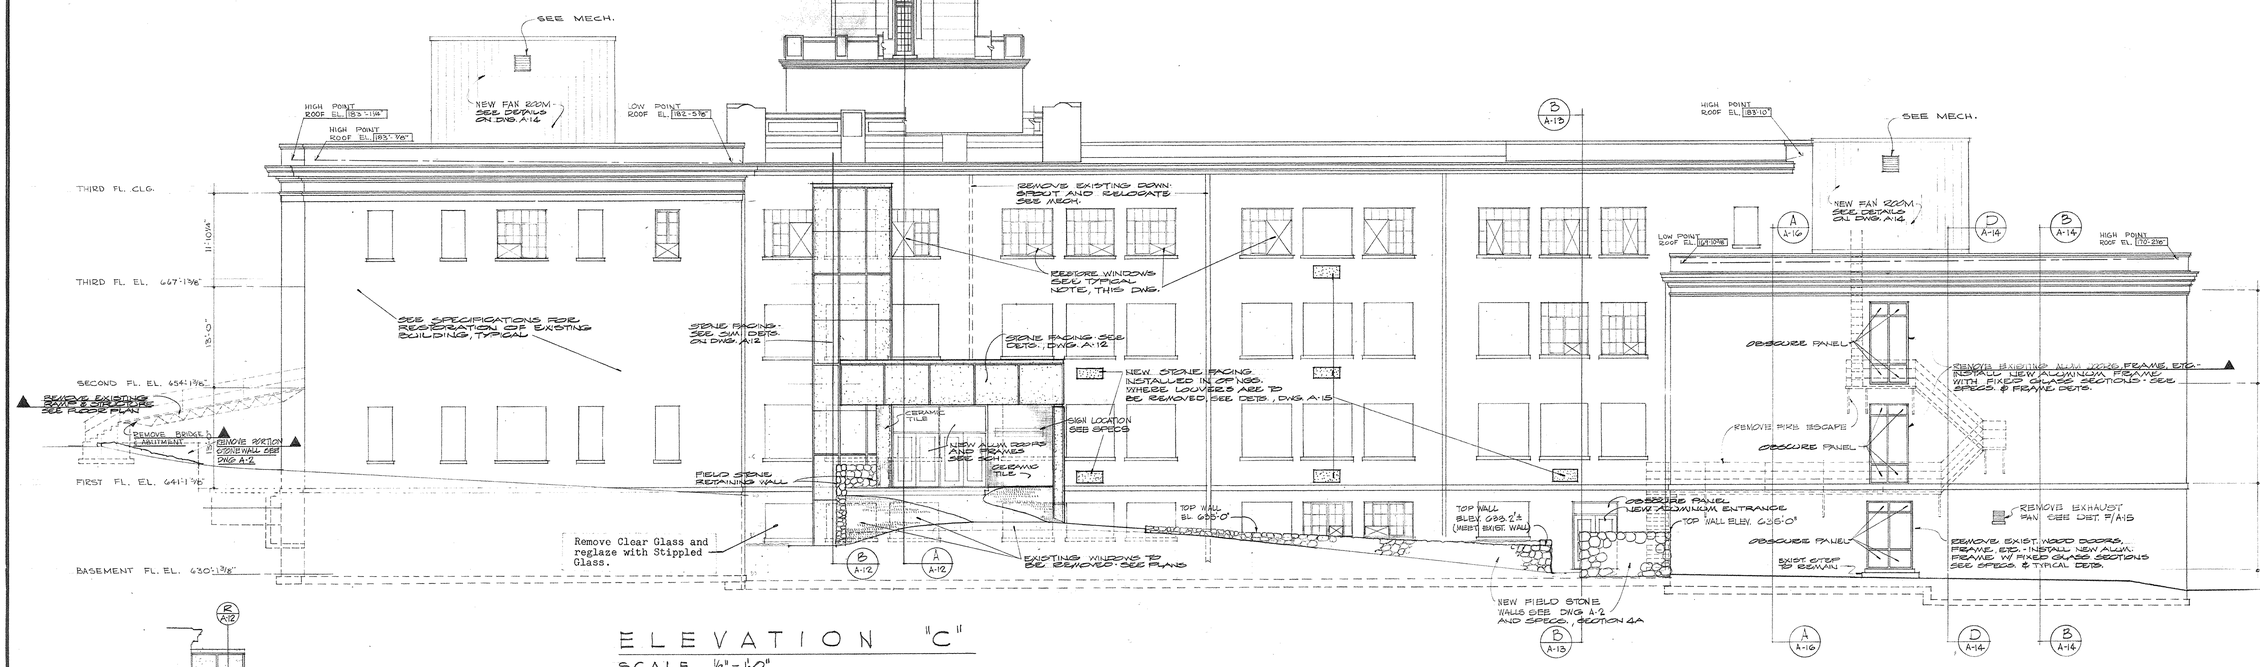

ELEVATION "C"

SCALE 1/8" = 1'-0"

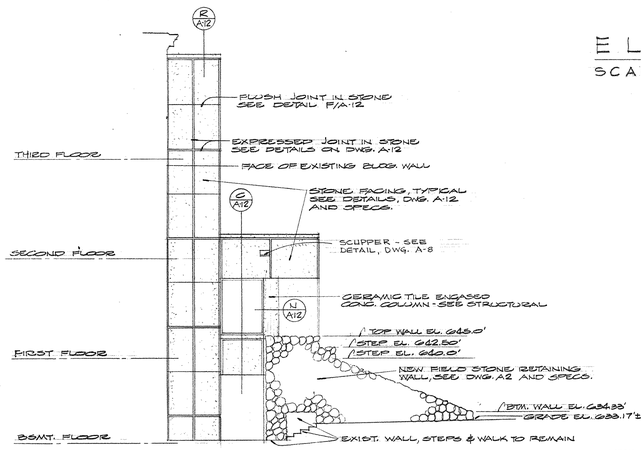

ELEVATION "H"

SCALE 1/8" = 1'-0"

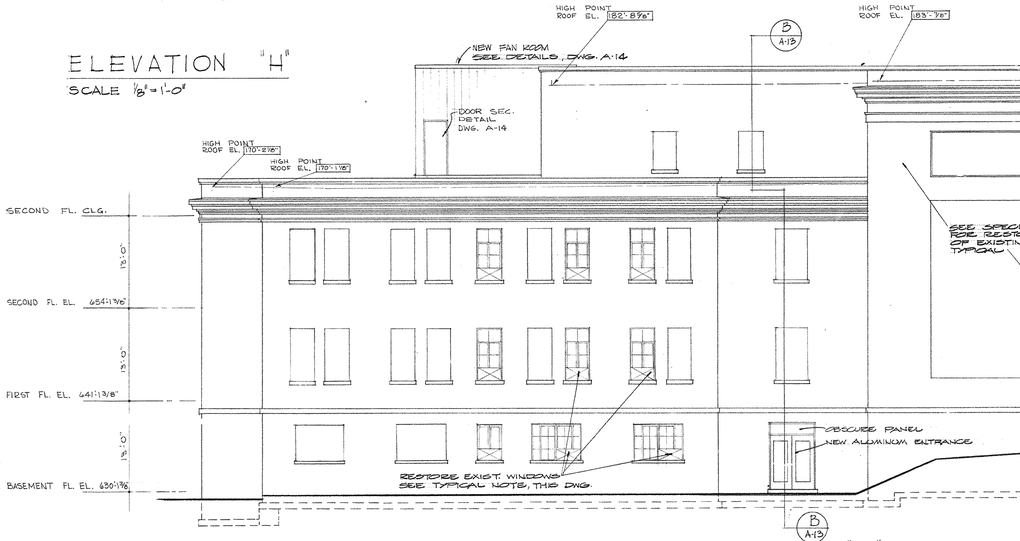

ELEVATION "A"

SCALE 1/8" = 1'-0"

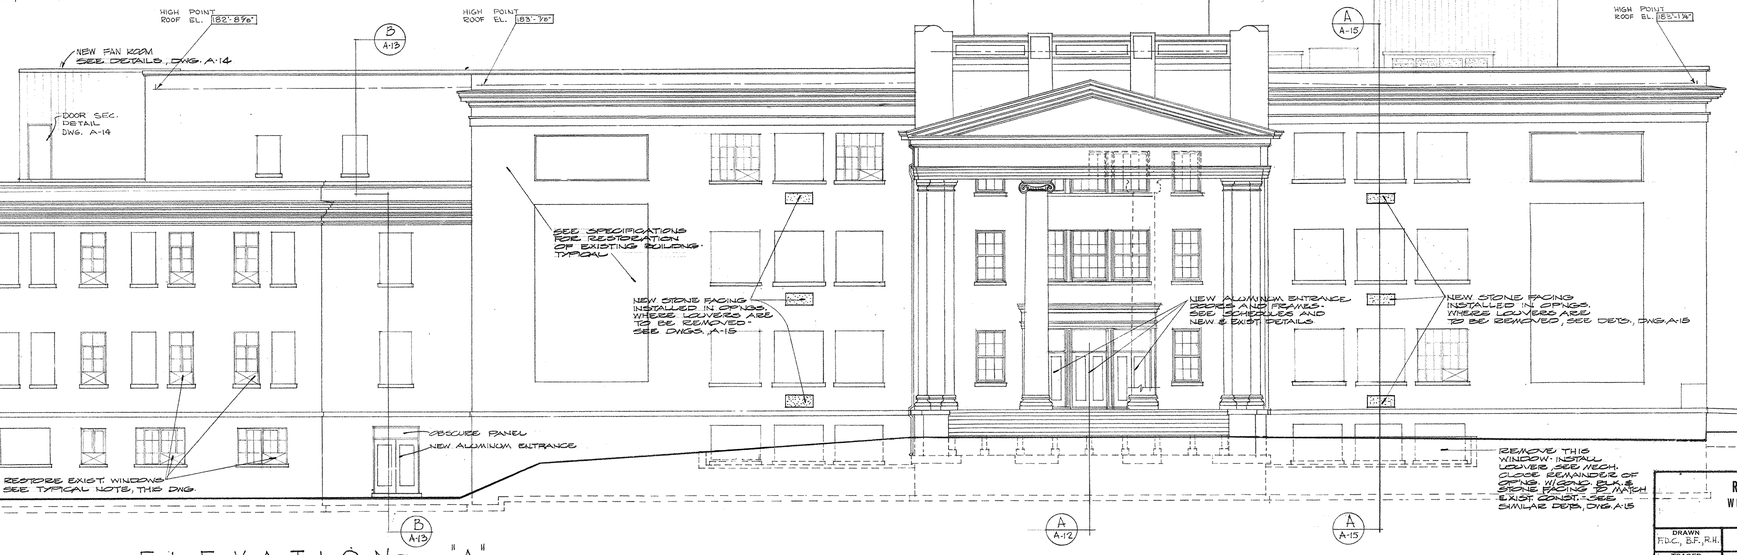

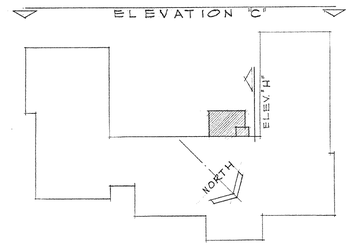

KEY PLAN

NOTE

BOXES IN WINDOW INDICATE AREAS OF WINDOW DISTURBED WHEN AIR CONDITIONERS REMOVED BY OWNER & NOT NECESSARILY THE SIZE OF THE A/C. THESE WINDOWS TO BE RESTORED TO ORIGINAL CONDITION - SEE SPECS

I certify that these are AS BUILT DRAWINGS to the best of my knowledge and belief.

FRANK D. CAIN JR. REGISTERED No. 488 COMMONWEALTH OF KENTUCKY ARCHITECT

RENOVATION OF CHERRY HALL
WESTERN KENTUCKY UNIVERSITY
BOWLING GREEN, KENTUCKY

DRAWN F.D.C., B.F., R.H.	**ELEVATIONS**	DATE 4-5-72
TRACED R.H., S.D.	FRANK D. CAIN JR., A. I. A. ARCHITECT Bowling Green, Kentucky	SCALE AS NOTED
CHECKED F.D.C. / F.D.C.		SPEC., NO. 7201
	COMMONWEALTH OF KENTUCKY DEPARTMENT OF FINANCE DIVISION OF ENGINEERING FRANKFORT, KENTUCKY	DRAWING NO. A-9 OF 22

APPROVED BY _____ AGENCY HEAD DATE 6-12-72
APPROVED BY _____ CHIEF OF STAFF DATE 6-22-72

R-2353

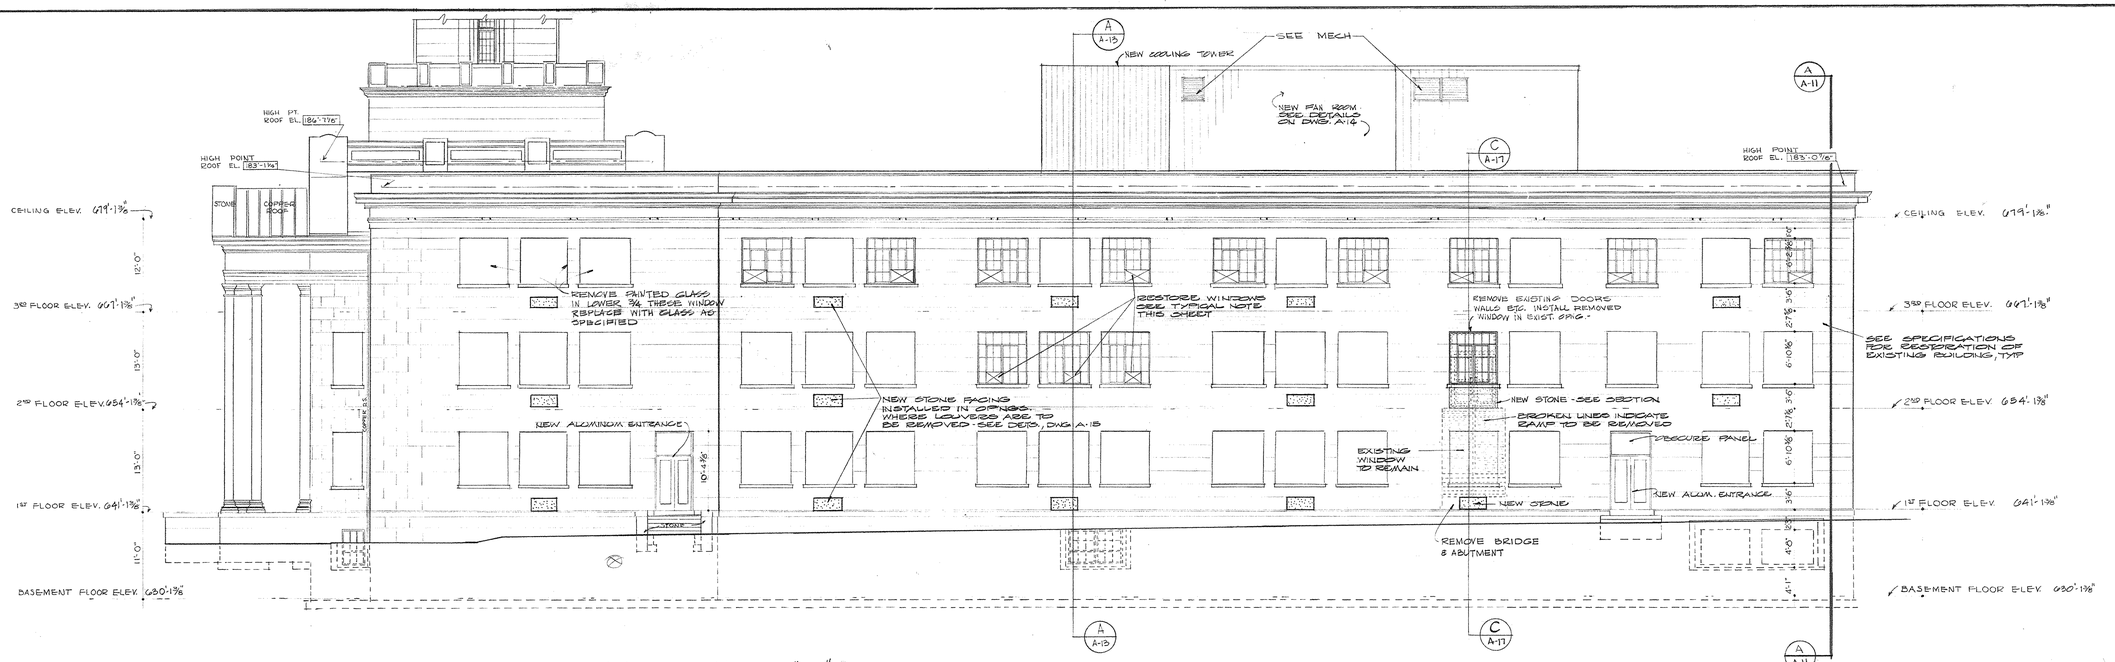

ELEVATION "G"

SCALE ⅛" = 1'-0"

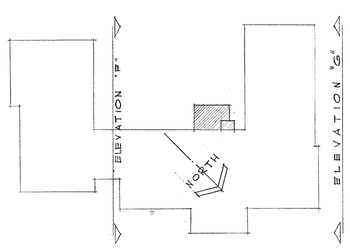

KEY PLAN

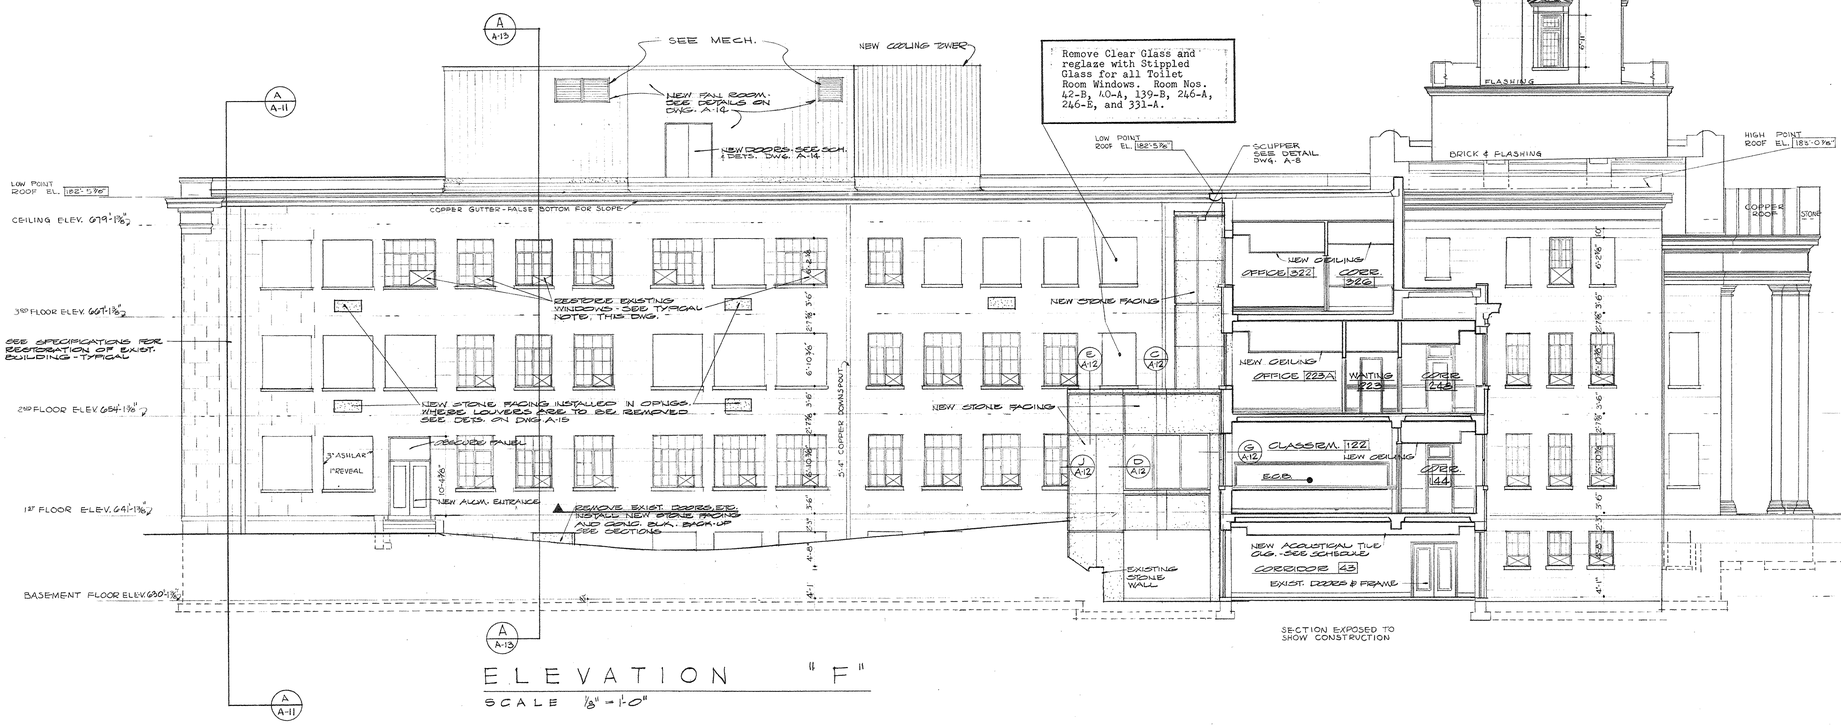

ELEVATION "F"

SCALE ⅛" = 1'-0"

SECTION EXPOSED TO SHOW CONSTRUCTION

I certify that these are AS BUILT DRAWINGS to the best of my knowledge and belief.

NOTE!

☒ BOXES IN WINDOW INDICATE AREAS OF WINDOW DISTURBED WHEN AIR CONDITIONERS REMOVED BY OWNER & NOT NECESSARILY THE SIZE OF THE A/C. THESE WINDOWS TO BE RESTORED TO ORIGINAL CONDITION - SEE SPECS

FRANK D. CAIN JR. REGISTERED No. 488 COMMONWEALTH OF KENTUCKY ARCHITECT

RENOVATION OF CHERRY HALL
WESTERN KENTUCKY UNIVERSITY
BOWLING GREEN, KENTUCKY

DRAWN T.D.C., B.F., R.H.	**ELEVATIONS**	DATE 4-5-72
TRACED R.H., S.D.	FRANK D. CAIN JR., A. I. A. ARCHITECT BOWLING GREEN, KENTUCKY	SCALE AS NOTED
CHECKED		SPEC. NO. 42-101
	COMMONWEALTH OF KENTUCKY DEPARTMENT OF FINANCE DIVISION OF ENGINEERING FRANKFORT, KENTUCKY	DRAWING NO. A-10 OF 22

APPROVED BY _____ AGENCY HEAD DATE APR 6 1972

APPROVED BY _____ CHIEF OF STAFF DATE 4/5/72

R-2354

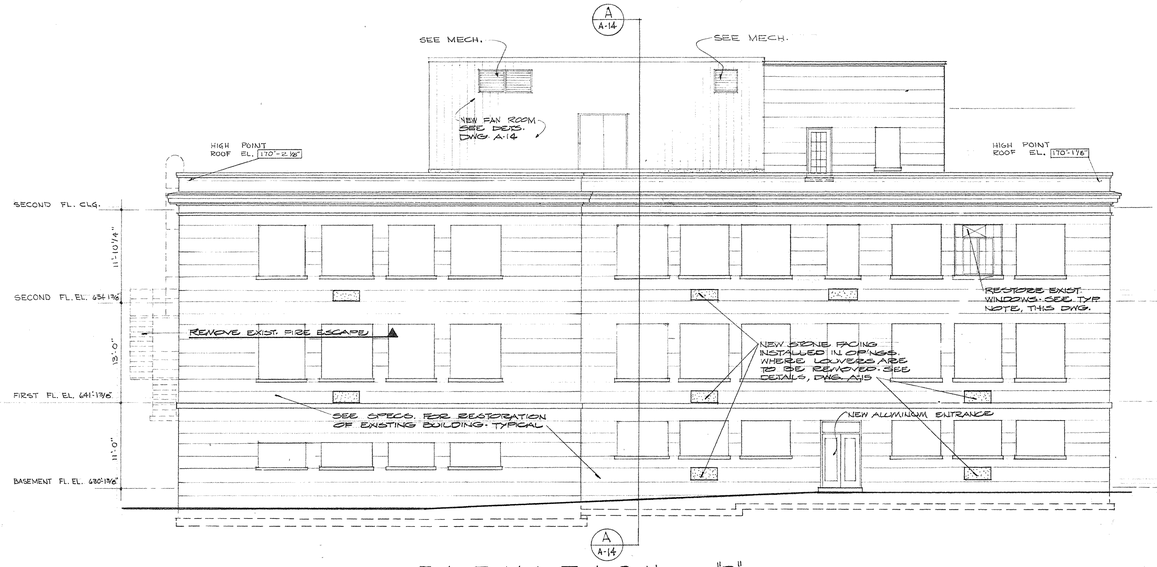

ELEVATION "B"

SCALE 1/8" = 1'-0"

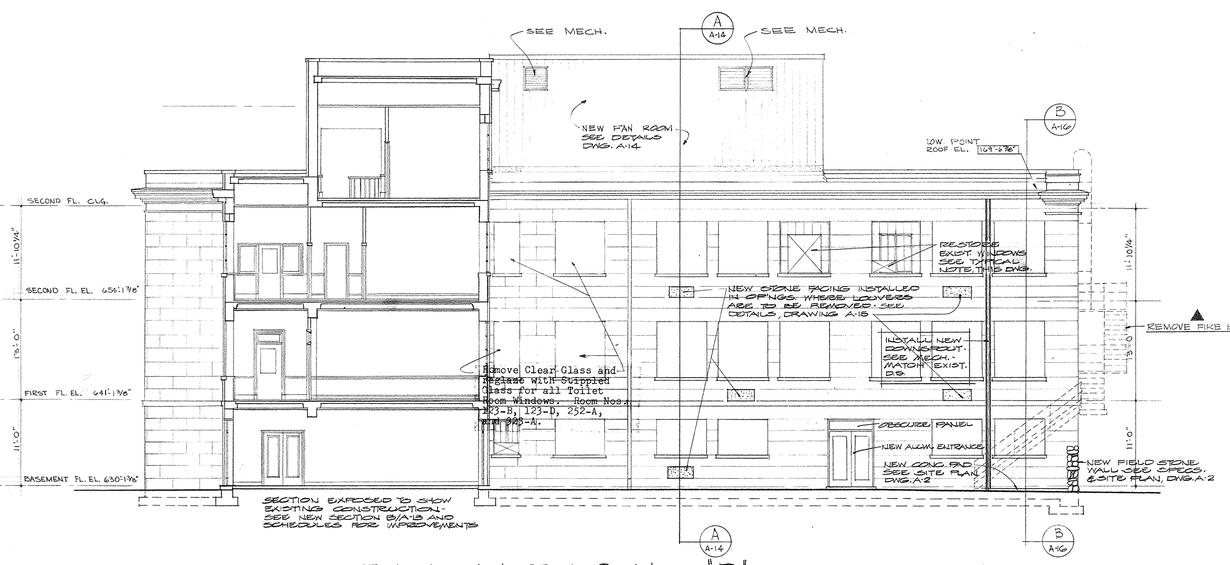

ELEVATION "D"

SCALE 1/8" = 1'-0"

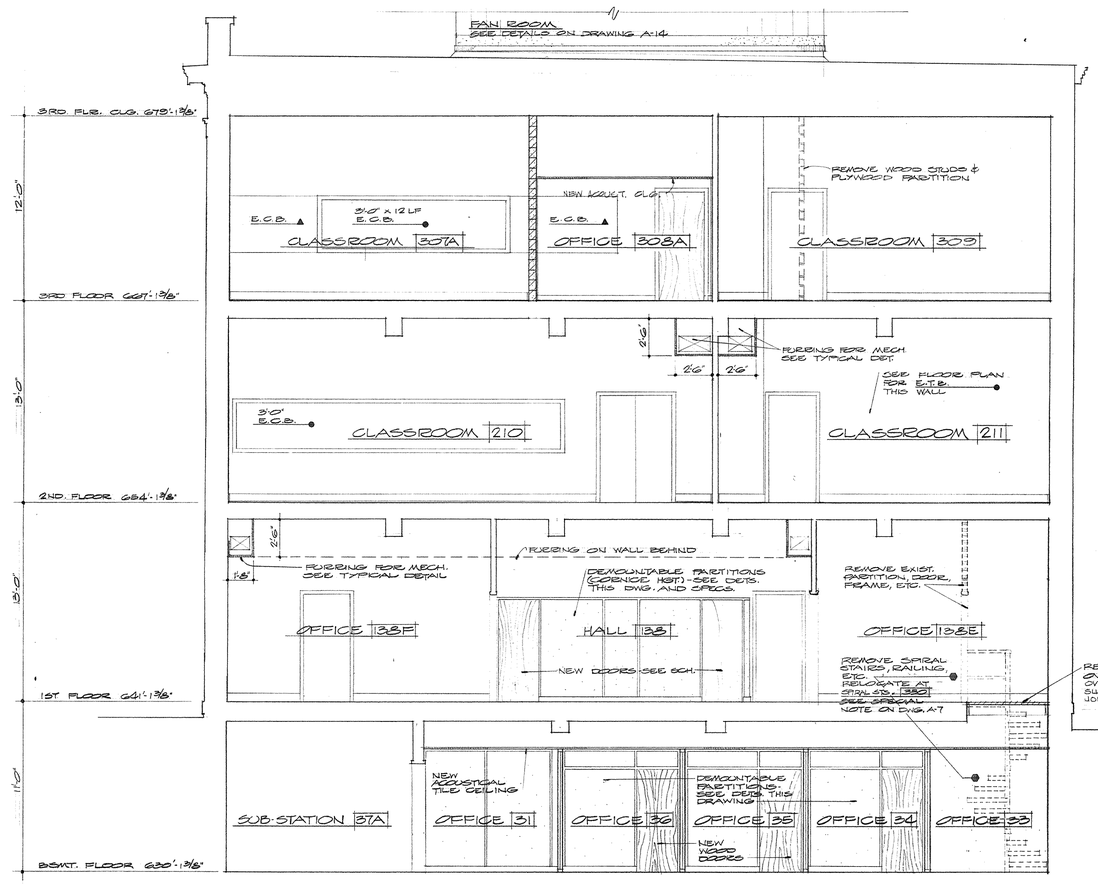

SECTION A A-11

SCALE 1/4"=1'-0"

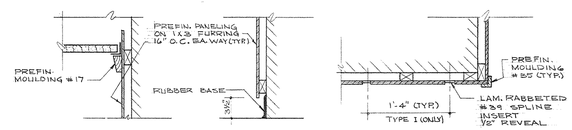

PREFINISHED PANELING DETAILS - TYPE 1

SCALE: 1" = 1'-0"

PANELING - TYPE 2

SCALE: 1" = 1'-0"

WINDOW SILL (5)

JAMB SIMILAR

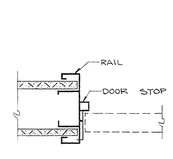

DOOR JAMB (6)

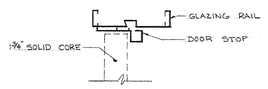

DOOR HEAD (1)

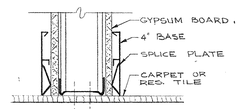

BASE (7)

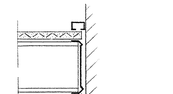

JAMB (8)

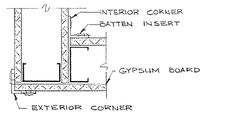

INT. EXT. CORNER (2)

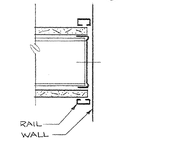

JAMB @ WALL (9)

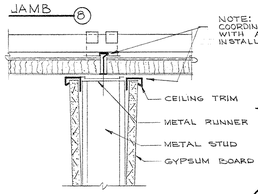

HEAD (10)

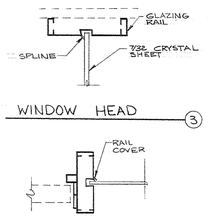

WINDOW HEAD (3)

DOOR & GLASS MULLION (4)

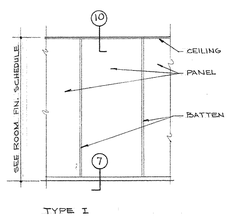

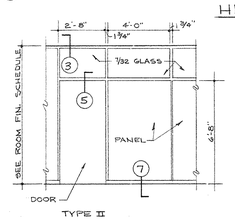

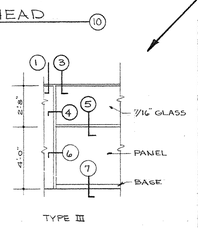

DEMOUNTABLE WALL ELEVATIONS & DETAILS

SCALE: 1/4" = 1'-0"

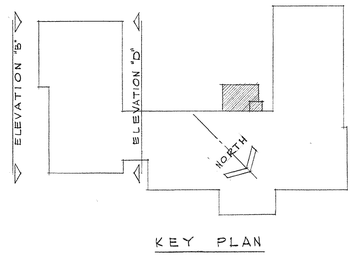

KEY PLAN

NOTE

BOXES IN WINDOW INDICATE AREAS OF WINDOW DISTURBED WHEN AIR CONDITIONERS INSTALLED BY OWNER & NOT NECESSARILY THE SIZE OF THE A/C. THESE WINDOWS TO BE RESTORED TO ORIGINAL CONDITION. SEE SPECS

DEMOUNTABLE PARTITION NOTES:

1. All Demountable Partitions go to Ceiling, unless otherwise noted to be Type III. See Room Finish Schedule and Details for ceiling heights.
2. All Demountable Partitions along Circulation Corridors, formed by demountable partitions, shall be Type II with light opening at Ceiling.
3. Demountable Partitions on the Third Floor shall be Type I.
4. Cornice height Partitions, Type III, occur on the First Floor, and should be used for Offices Nos. 138C, 138D, 138A, and 137.
5. Demountable Partitions between offices shall be Type I.

I certify that these are AS BUILT DRAWINGS to the best of my knowledge and belief.

FRANK D. CAIN JR. REGISTERED No. 488 COMMONWEALTH OF KENTUCKY ARCHITECT

RENOVATION OF CHERRY HALL
WESTERN KENTUCKY UNIVERSITY
BOWLING GREEN, KENTUCKY

DRAWN F.D.C., B.F.	ELEVATIONS	DATE 4-5-72
TRACED R.H., S.D.	FRANK D. CAIN JR., A. I. A. ARCHITECT BOWLING GREEN, KENTUCKY	SCALE AS NOTED
CHECKED 6/7/72		SPEC. NO. 72-01
	COMMONWEALTH OF KENTUCKY DEPARTMENT OF FINANCE DIVISION OF ENGINEERING FRANKFORT, KENTUCKY	DRAWING NO. A-11 OF 22

APPROVED BY _____ AGENCY HEAD DATE APR 6 1972

APPROVED BY _____ CHIEF OF STAFF DATE 4/4/72

R-2355

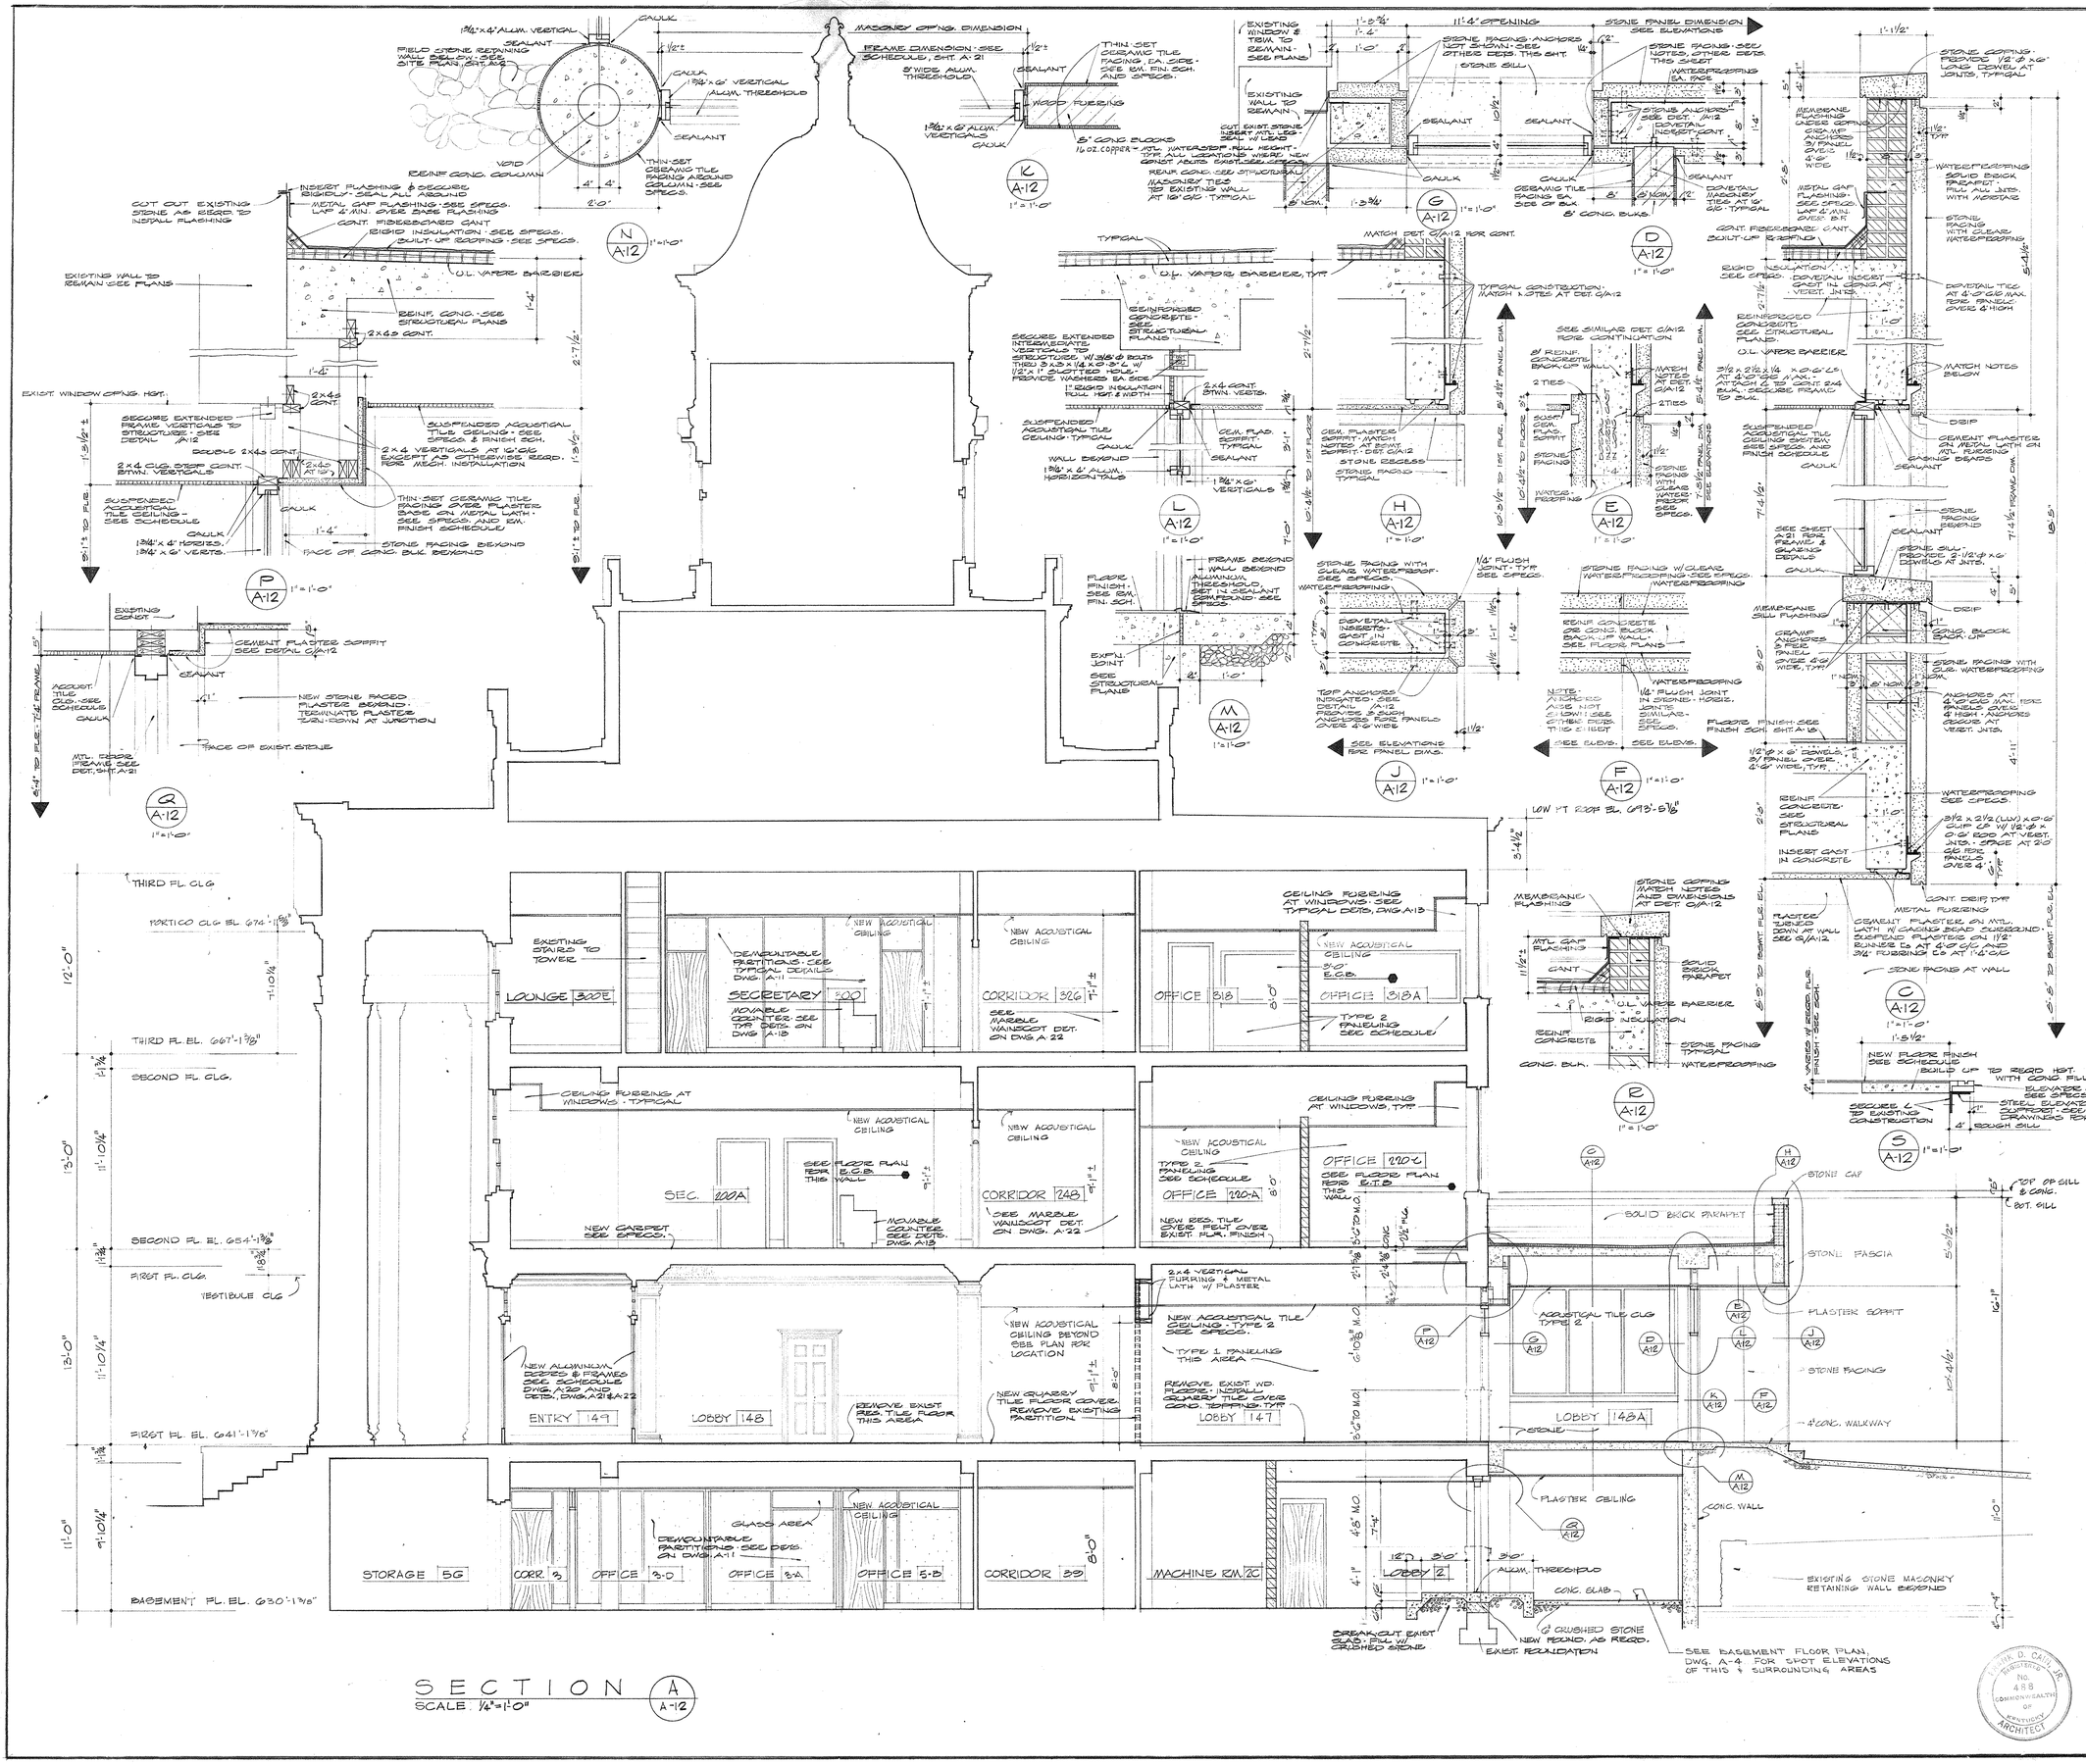

	RENOVATION OF CHERRY HALL WESTERN KENTUCKY UNIVERSITY BOWLING GREEN, KENTUCKY	
DRAWN RDC., E.R.	**SECTIONS**	DATE 4-5-72
TRACED S.D./B.F.	FRANK D. CAIN JR., A. I. A. ARCHITECT BOWLING GREEN, KENTUCKY	SCALE AS NOTED
CHECKED 6/FDC		SPEC. NO. 7201
	COMMONWEALTH OF KENTUCKY DEPARTMENT OF FINANCE DIVISION OF ENGINEERING FRANKFORT, KENTUCKY	DRAWING NO. A-12 OF 22

APPROVED BY _____ AGENCY HEAD _____ DATE APR 6 1972

APPROVED BY _____ CHIEF OF STAFF _____ DATE 4-14-72

R-2356

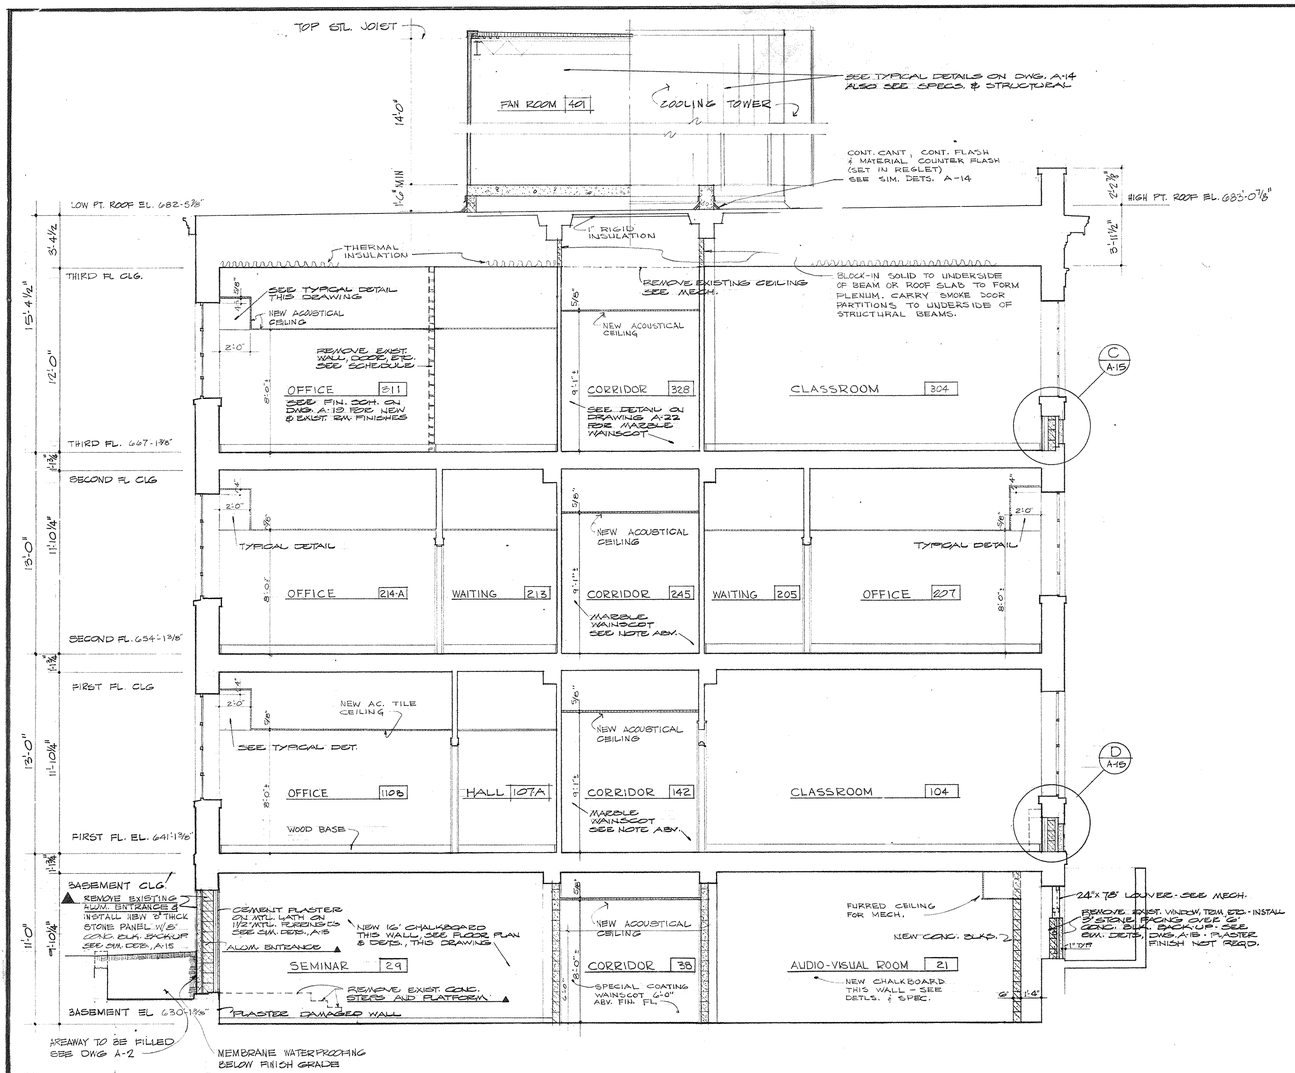

SECTION (A) A-13
SCALE 1/4"=1'-0"

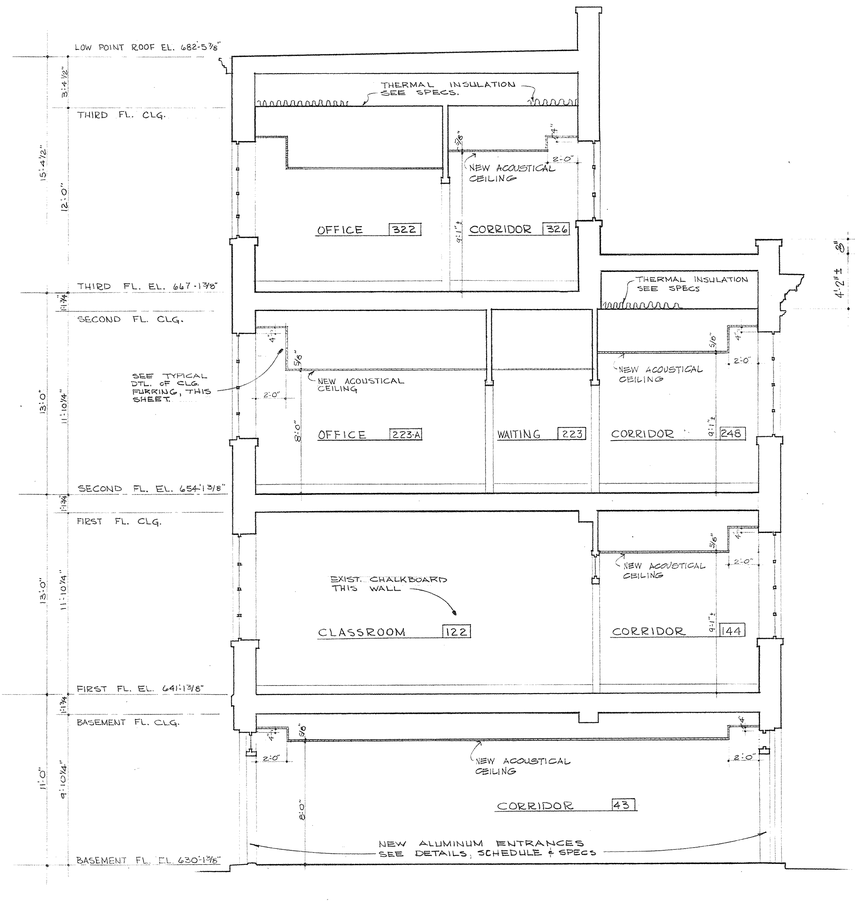

SECTION (B) A-13
SCALE 1/4"=1'-0"

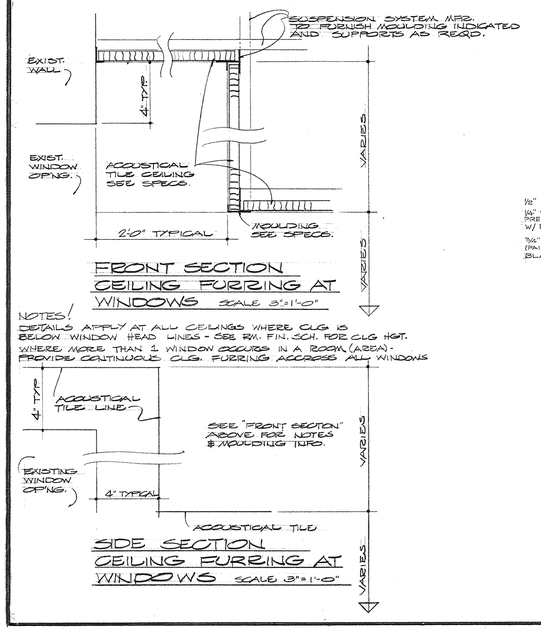

FRONT SECTION CEILING FURRING AT WINDOWS
SCALE 3"=1'-0"

NOTES:
DETAILS APPLY AT ALL CEILINGS WHERE CLG IS BELOW WINDOW HEAD HGHT. - SEE RM. FIN. SCH. FOR CLG HGT.
WHERE MORE THAN 1 WINDOW OCCURS IN A ROOM (AREA) - PROVIDE CONTINUOUS CLG. FURRING ACROSS ALL WINDOWS

SIDE SECTION CEILING FURRING AT WINDOWS
SCALE 3"=1'-0"

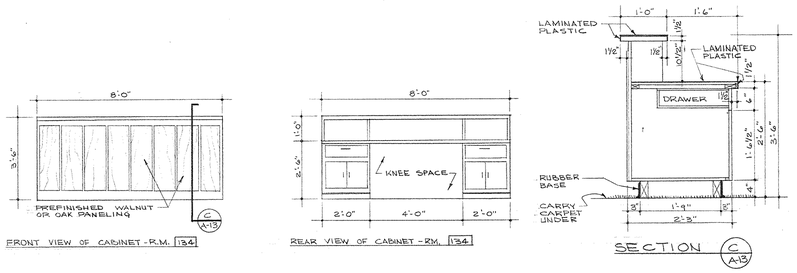

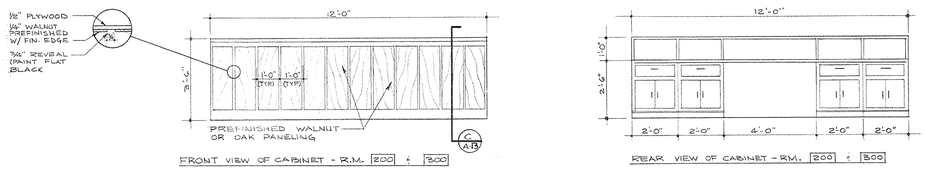

MOVABLE COUNTER ELEVATIONS & SECTION
SCALE - ELEVATIONS: 3/8"=1'-0" - SECTION: 3/4"=1'-0"

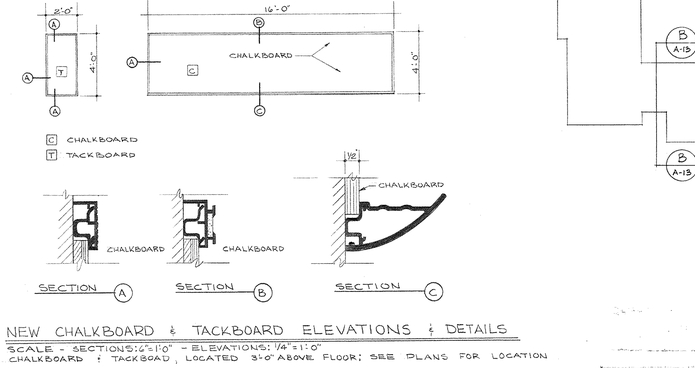

NEW CHALKBOARD & TACKBOARD ELEVATIONS & DETAILS
SCALE - SECTIONS: 1½"=1'-0" - ELEVATIONS: 1/4"=1'-0"
CHALKBOARD & TACKBOAD, LOCATED 3'-0" ABOVE FLOOR; SEE PLANS FOR LOCATION

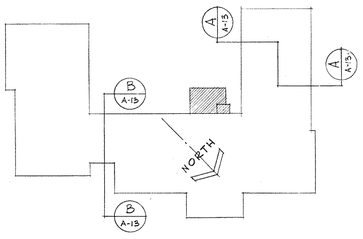

I certify that these are AS BUILT DRAWINGS to the best of my knowledge and belief.

FRANK D. CAIN, JR. REGISTERED No. 438 COMMONWEALTH OF KENTUCKY ARCHITECT

RENOVATION OF CHERRY HALL
WESTERN KENTUCKY UNIVERSITY
BOWLING GREEN, KENTUCKY

DRAWN FDC., E.F.	**SECTIONS**	DATE 4-5-72
TRACED S.D.	FRANK D. CAIN JR., A. I. A. ARCHITECT BOWLING GREEN, KENTUCKY	SCALE AS NOTED
CHECKED [illegible]		SPEC. NO. 7201
	COMMONWEALTH OF KENTUCKY DEPARTMENT OF FINANCE DIVISION OF ENGINEERING FRANKFORT, KENTUCKY	DRAWING NO. A-13 OF 22

APPROVED BY [signature] AGENCY HEAD DATE APR 6 1972
APPROVED BY [signature] CHIEF OF STAFF DATE 3-14-72

R-2357

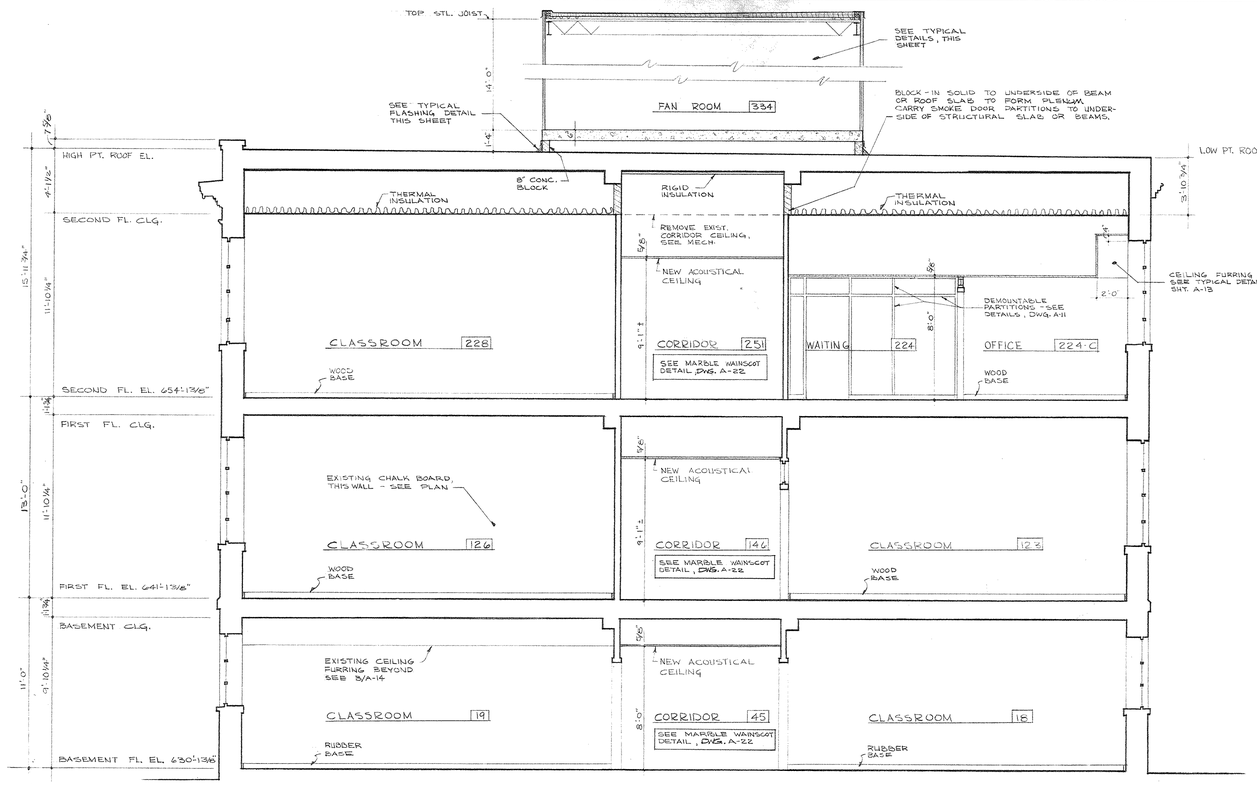

SECTION

SCALE: 1/4" = 1'-0"

A / A-14

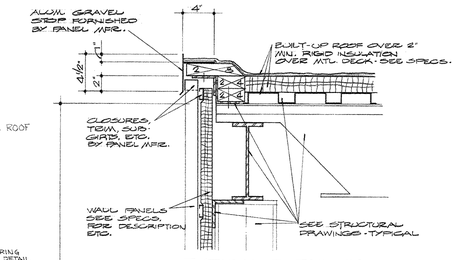

TYPICAL DETAIL AT ROOF

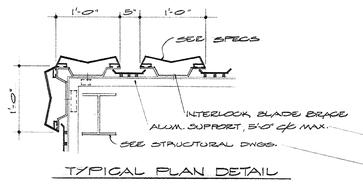

TYPICAL PLAN DETAIL

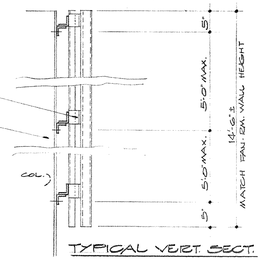

TYPICAL VERT. SECT.

COOLING TOWER WALL DETAILS

SCALE 1" = 1'-0"

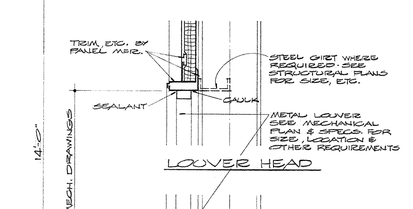

LOUVER HEAD

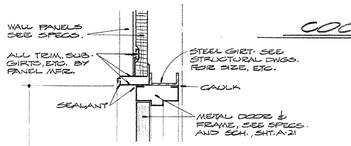

DOOR HEAD

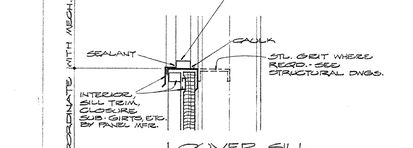

LOUVER SILL

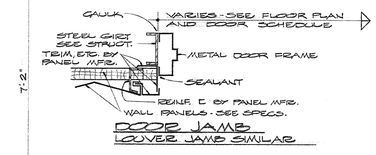

DOOR JAMB
LOUVER JAMB SIMILAR

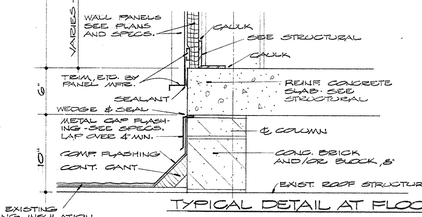

TYPICAL DETAIL AT FLOOR

PATCH EXISTING ROOFING, INSULATION AND DECK DAMAGED BY THIS CONST. LEAVE IN SOUND, WATERPROOF CONDITION. SEE SPECS.

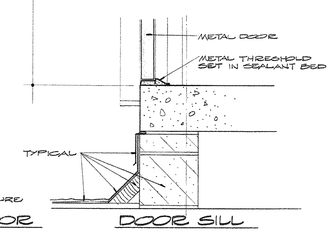

DOOR SILL

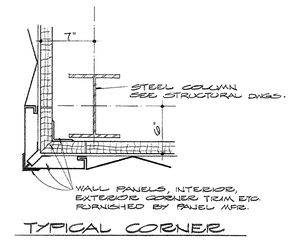

TYPICAL CORNER

TYPICAL FAN-ROOM WALL DETAILS

SCALE 1 1/2" = 1'-0"

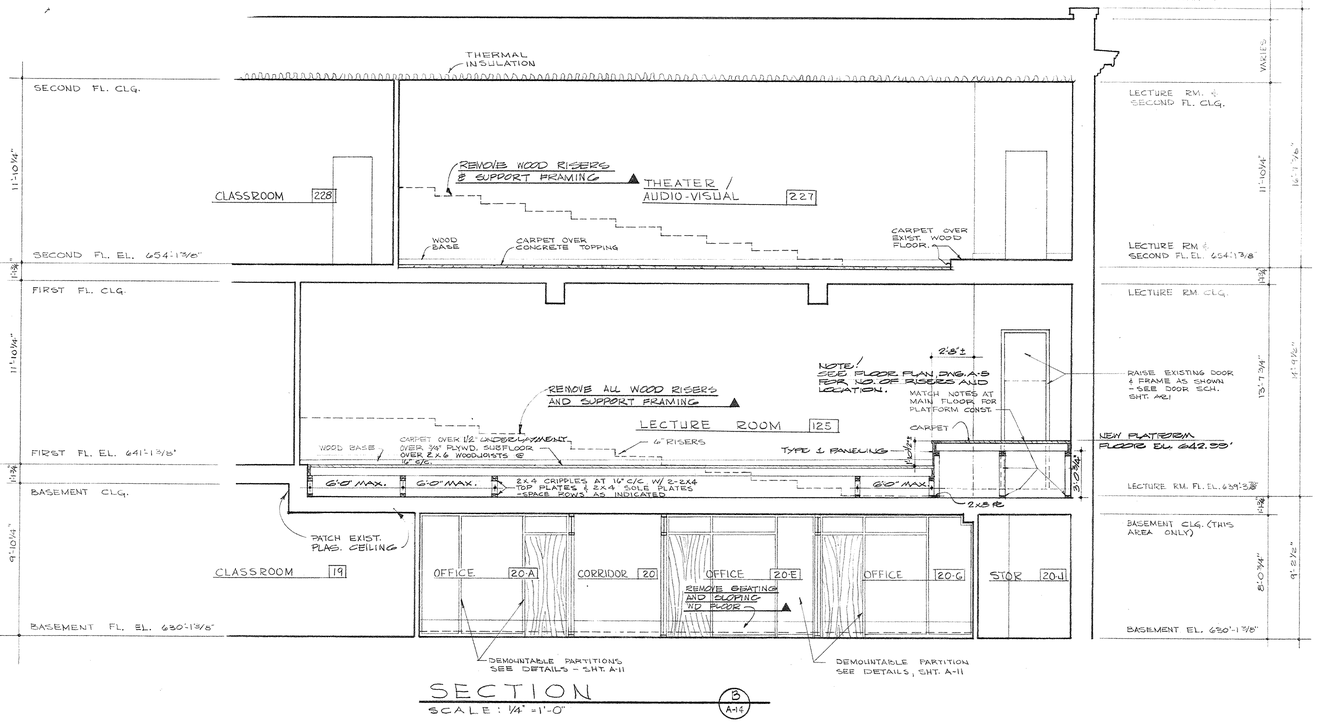

SECTION

SCALE: 1/4" = 1'-0"

B / A-14

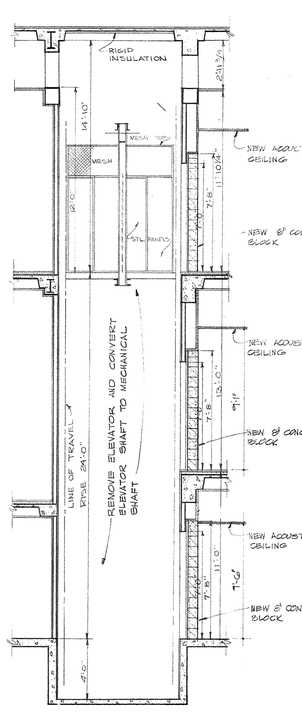

SECTION

SCALE: 1/4" = 1'-0"

C / A-14

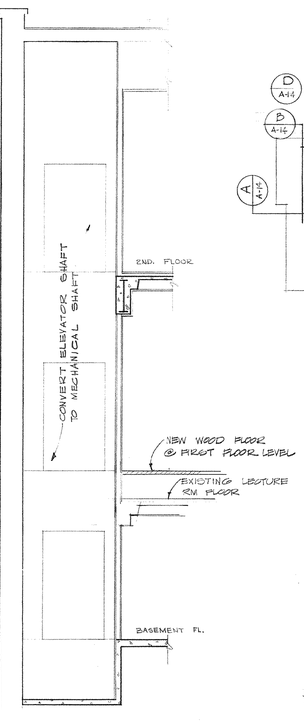

SECTION

SCALE: 1/4" = 1'-0"

D / A-14

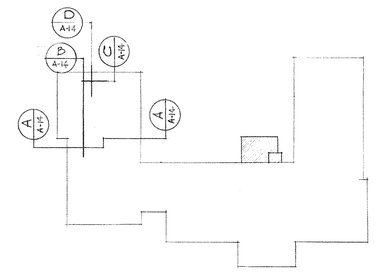

KEY PLAN

FRANK D. CAIN JR. No. 488 COMMONWEALTH OF KENTUCKY REGISTERED ARCHITECT

I certify that these are AS BUILT DRAWINGS to best of my knowledge and belief.

Frank D. Cain Jr.

RENOVATION OF CHERRY HALL
WESTERN KENTUCKY UNIVERSITY
BOWLING GREEN, KENTUCKY

DRAWN F.D.C., S.K.D.	**SECTIONS**	DATE 4-5-72
TRACED S.K.D.	FRANK D. CAIN JR., A. I. A. ARCHITECT BOWLING GREEN, KENTUCKY	SCALE AS NOTED
CHECKED F.D.C.		SPEC. NO. 7201
	COMMONWEALTH OF KENTUCKY DEPARTMENT OF FINANCE DIVISION OF ENGINEERING FRANKFORT, KENTUCKY	DRAWING NO. A-14 OF 22

APPROVED BY _____ AGENCY HEAD DATE 4/26/72

APPROVED BY _____ CHIEF OF STAFF DATE 4/26/72

R-2358

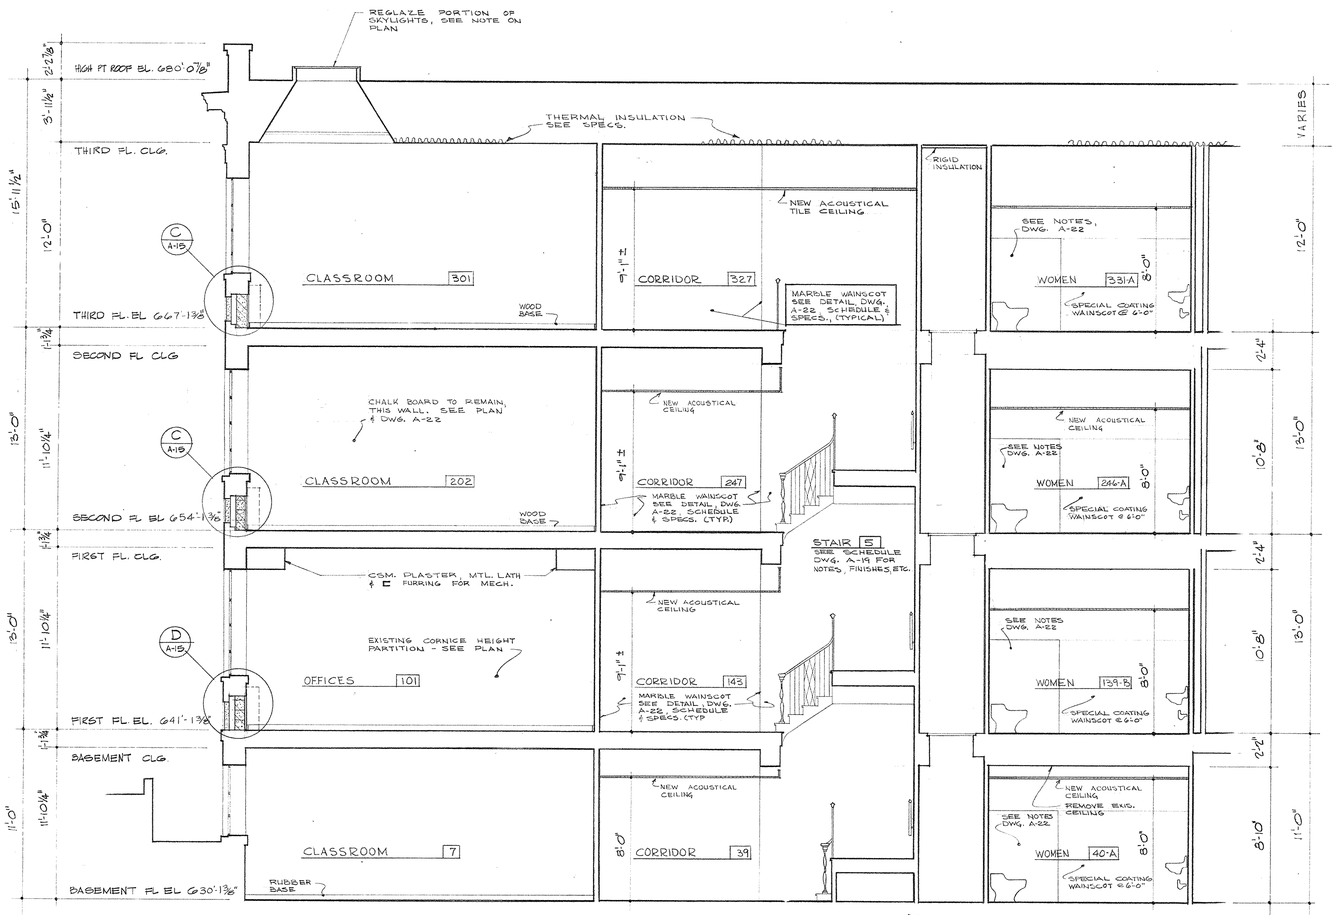

SECTION A
SCALE 1/4" = 1'-0" A-15

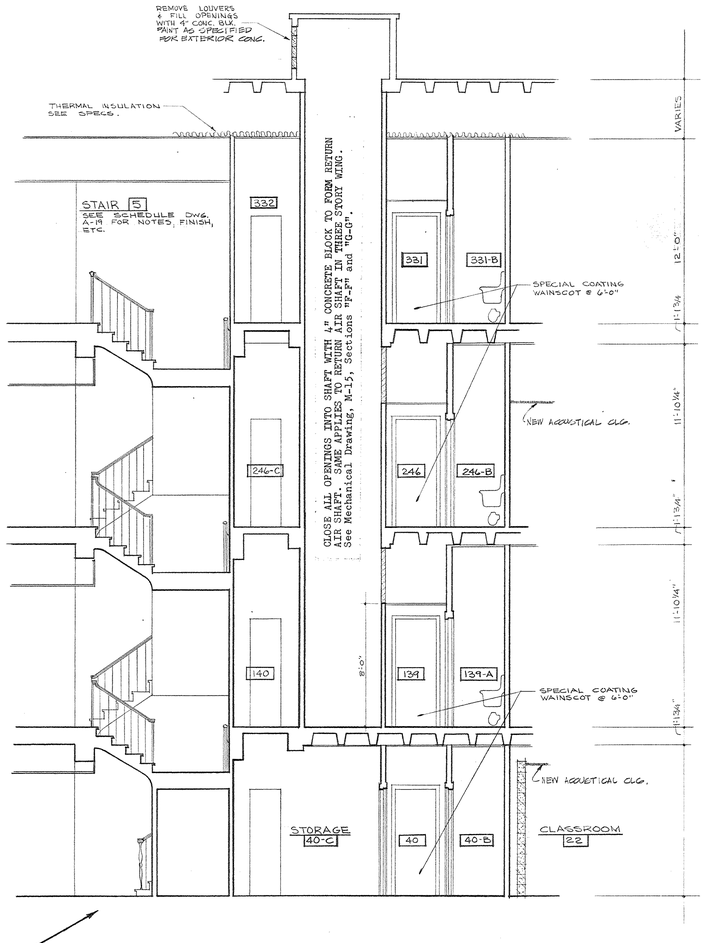

SECTION B
SCALE: 1/4" = 1'-0" A-13

STAIR NO. 4 AND STAIR NO. 5:

For Stair 4 and Stair 5, clean existing marble, treads, risers, trim, and wainscot. Remove from each tread, the two 3M Company stick-on abrasive strips and install new equal 3M Company abrasive strips, or equal. Clean existing metal balusters, but do not paint. Replace missing wood pinnacles and refinish wood hand rails.

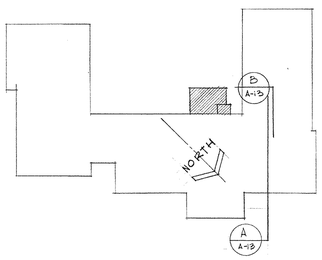

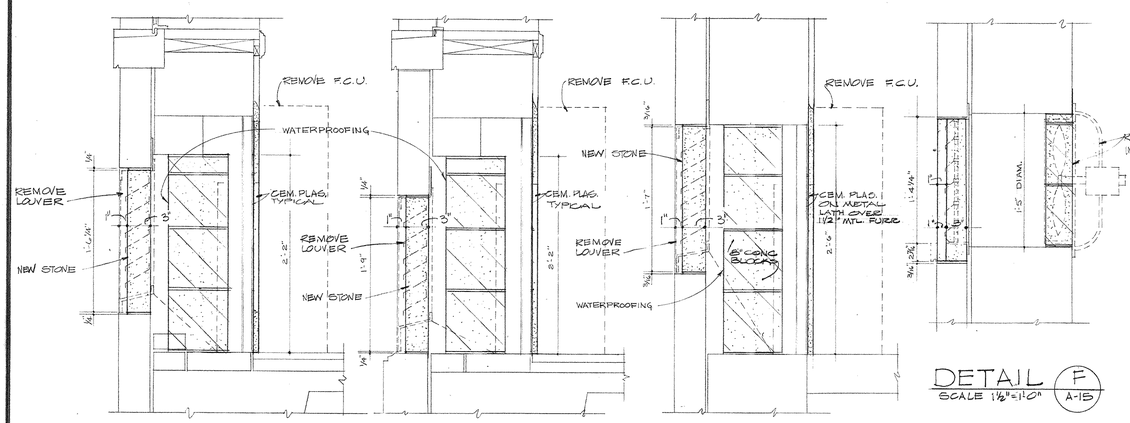

DETAIL C
SCALE 1 1/2"=1'-0" A-15
SECOND & THIRD FLOOR

DETAIL D
SCALE 1 1/2"=1'-0" A-15
FIRST FLOOR

DETAIL E
SCALE 1 1/2"=1'-0" A-15
BASEMENT

DETAIL F
SCALE 1 1/2"=1'-0" A-15

DETAILS OF OPENINGS WHERE UNIT HEATERS REMOVED

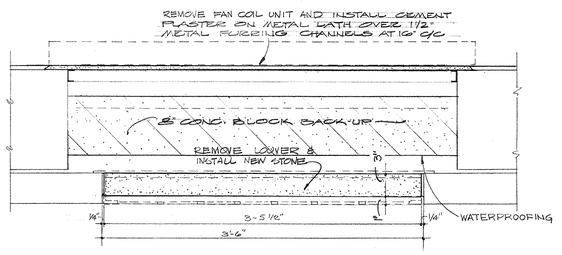

ALL FLOORS

PLAN - UNIT HEATER OPENINGS
SCALE 1 1/2" = 1'-0"

I certify that these are AS BUILT DRAWINGS to the best of my knowledge

FRANK D. CAIN, JR. REGISTERED No. 488 COMMONWEALTH OF KENTUCKY ARCHITECT

RENOVATION OF CHERRY HALL
WESTERN KENTUCKY UNIVERSITY
BOWLING GREEN, KENTUCKY

DRAWN F.D.C., B.F.	**SECTIONS**	DATE 4-5-72
TRACED W.H. S.D.	FRANK D. CAIN JR., A. I. A. ARCHITECT BOWLING GREEN, KENTUCKY	SCALE AS NOTED
CHECKED		SPEC. NO. 72-01
	COMMONWEALTH OF KENTUCKY DEPARTMENT OF FINANCE DIVISION OF ENGINEERING FRANKFORT, KENTUCKY	DRAWING NO. A-15 OF 22

APPROVED BY _____ AGENCY HEAD DATE APR 6 1972
APPROVED BY _____ CHIEF OF STAFF DATE 4-14-72

R-2359

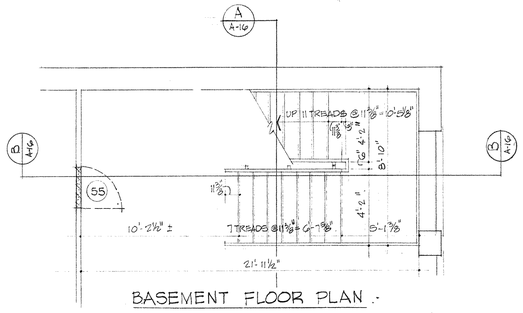

BASEMENT FLOOR PLAN

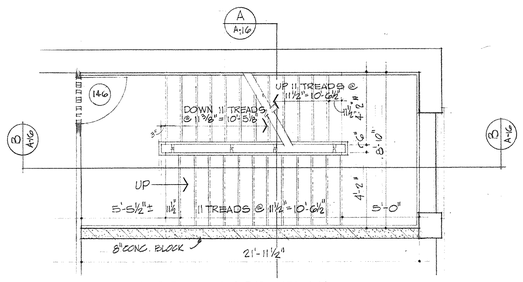

FIRST FLOOR PLAN

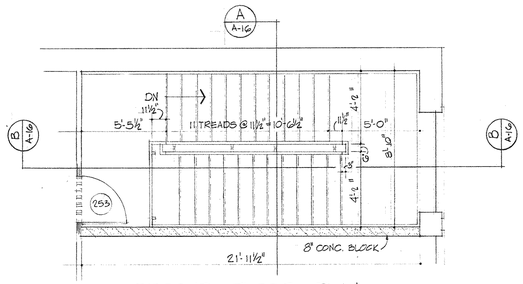

SECOND FLOOR PLAN

ENLARGED FLOOR PLANS-STAIR #1

SCALE 1/4" = 1'-0"

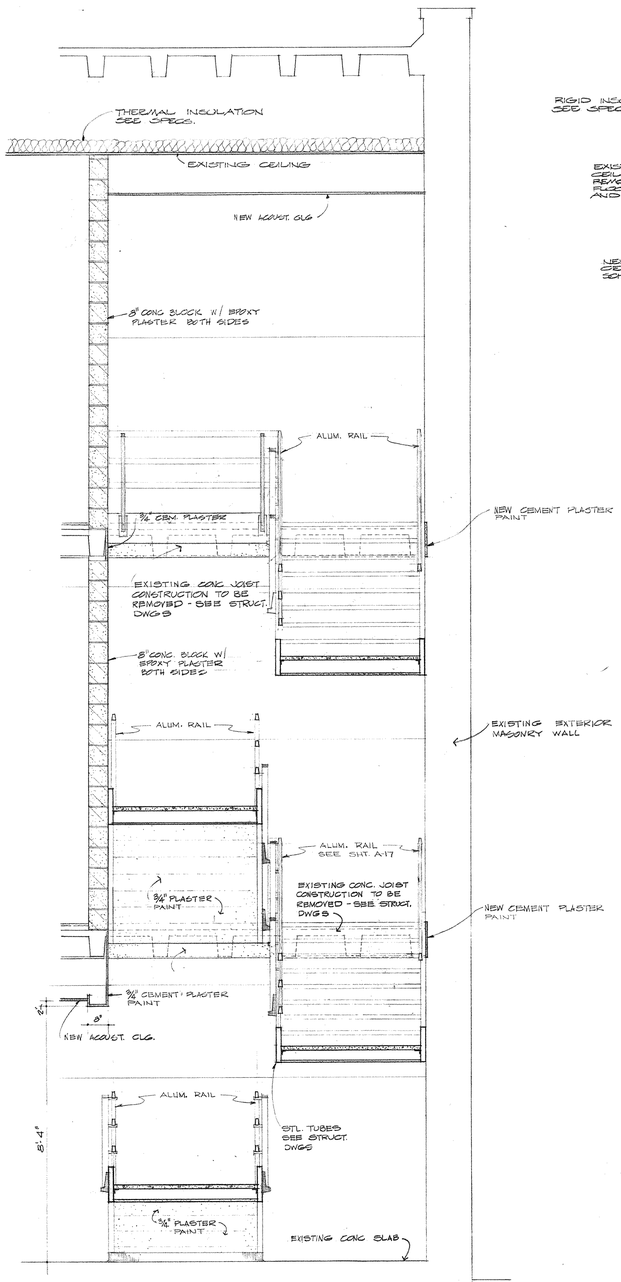

SECTION - STAIR #1 (A / A-16)

SCALE 1/2" = 1'-0"

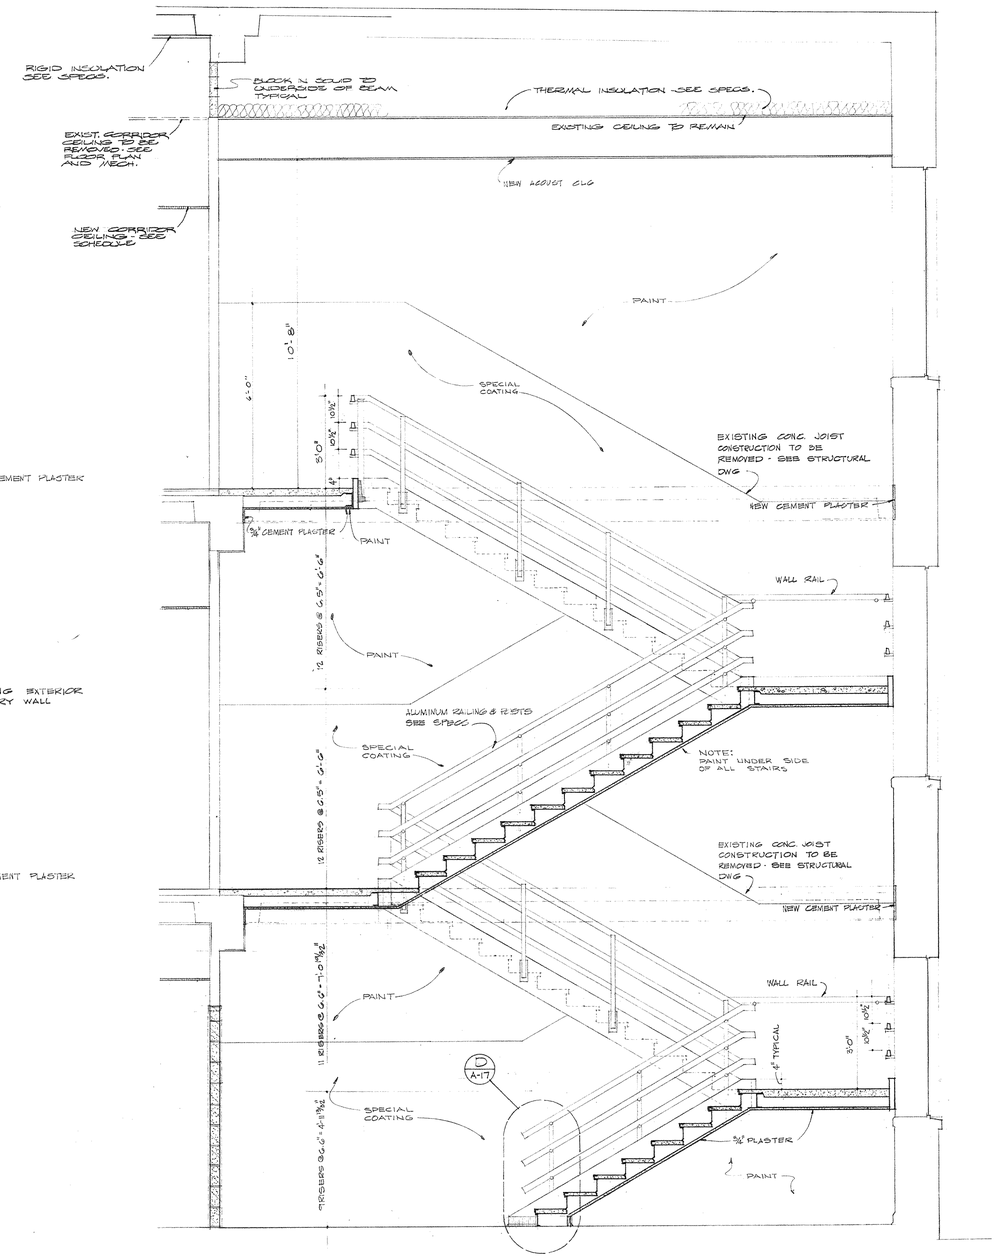

SECTION - STAIR #1 (B / A-16)

SCALE 1/2" = 1'-0"

I certify that these are AS BUILT DRAWINGS to the best of my knowledge

Frank D. Cain

FRANK D. CAIN JR. No. 433 COMMONWEALTH OF KENTUCKY ARCHITECT

RENOVATION OF CHERRY HALL
WESTERN KENTUCKY UNIVERSITY
BOWLING GREEN, KENTUCKY

DRAWN F.D.C., R.H.	**STAIR - 1 PLANS, SECTIONS & DETAIL**	DATE 4-5-72
TRACED S.D.	FRANK D. CAIN JR., A. I. A. ARCHITECT BOWLING GREEN, KENTUCKY	SCALE AS NOTED
CHECKED F.D.C.		SPEC. NO. 72.01
	COMMONWEALTH OF KENTUCKY DEPARTMENT OF FINANCE DIVISION OF ENGINEERING FRANKFORT, KENTUCKY	DRAWING NO. A-16 Of 22

APPROVED BY _____ AGENCY HEAD DATE APR 6 1972

APPROVED BY _____ CHIEF OF STAFF DATE _____

R-2360

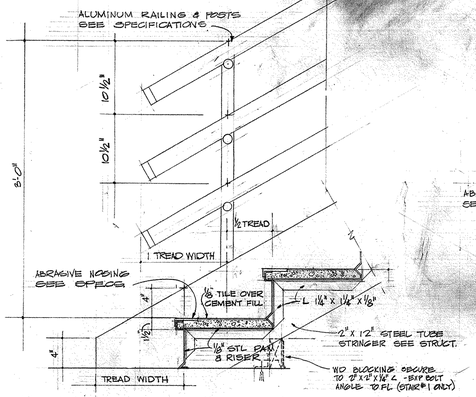

DETAIL (D) A-17
SCALE 1½"=1'-0"

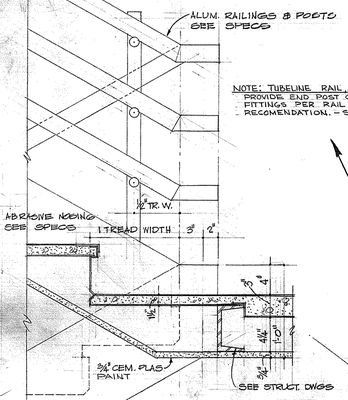

DETAIL (E) A-17
SCALE 1½"=1'-0"

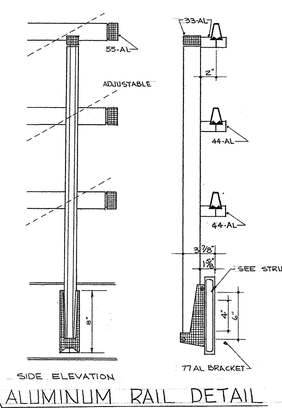

ALUMINUM RAIL DETAIL

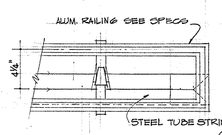

DETAIL (F) A-17
SCALE 1½"=1'-0"

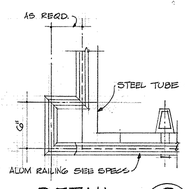

DETAIL (G) A-17
SCALE 1½"=1'-0"

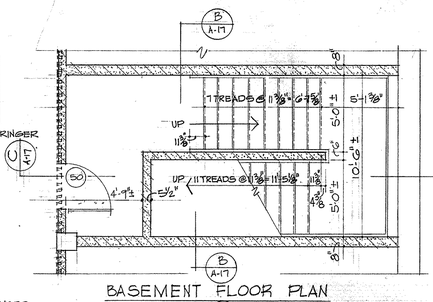

BASEMENT FLOOR PLAN

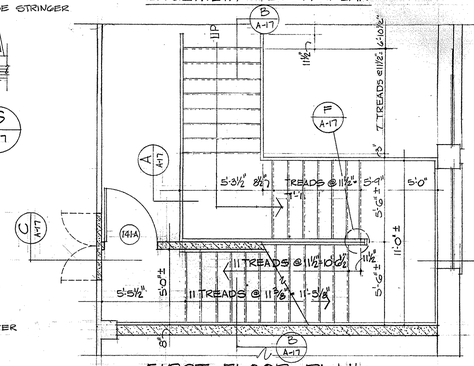

FIRST FLOOR PLAN

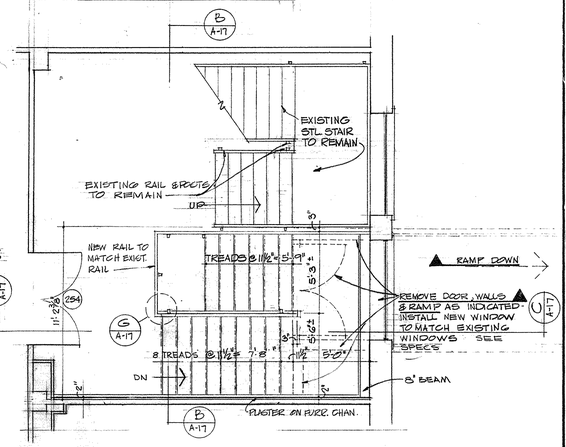

SECOND FLOOR PLAN

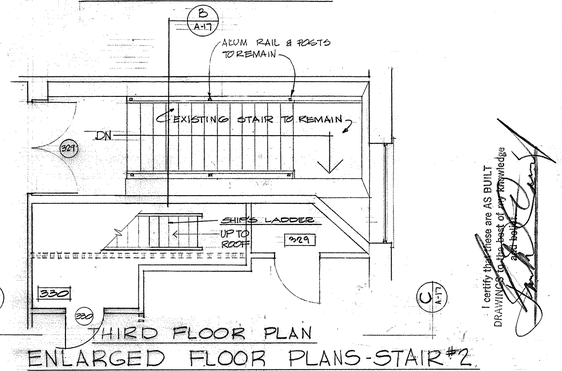

THIRD FLOOR PLAN

ENLARGED FLOOR PLANS - STAIR #2
SCALE 1½"=1'-0"

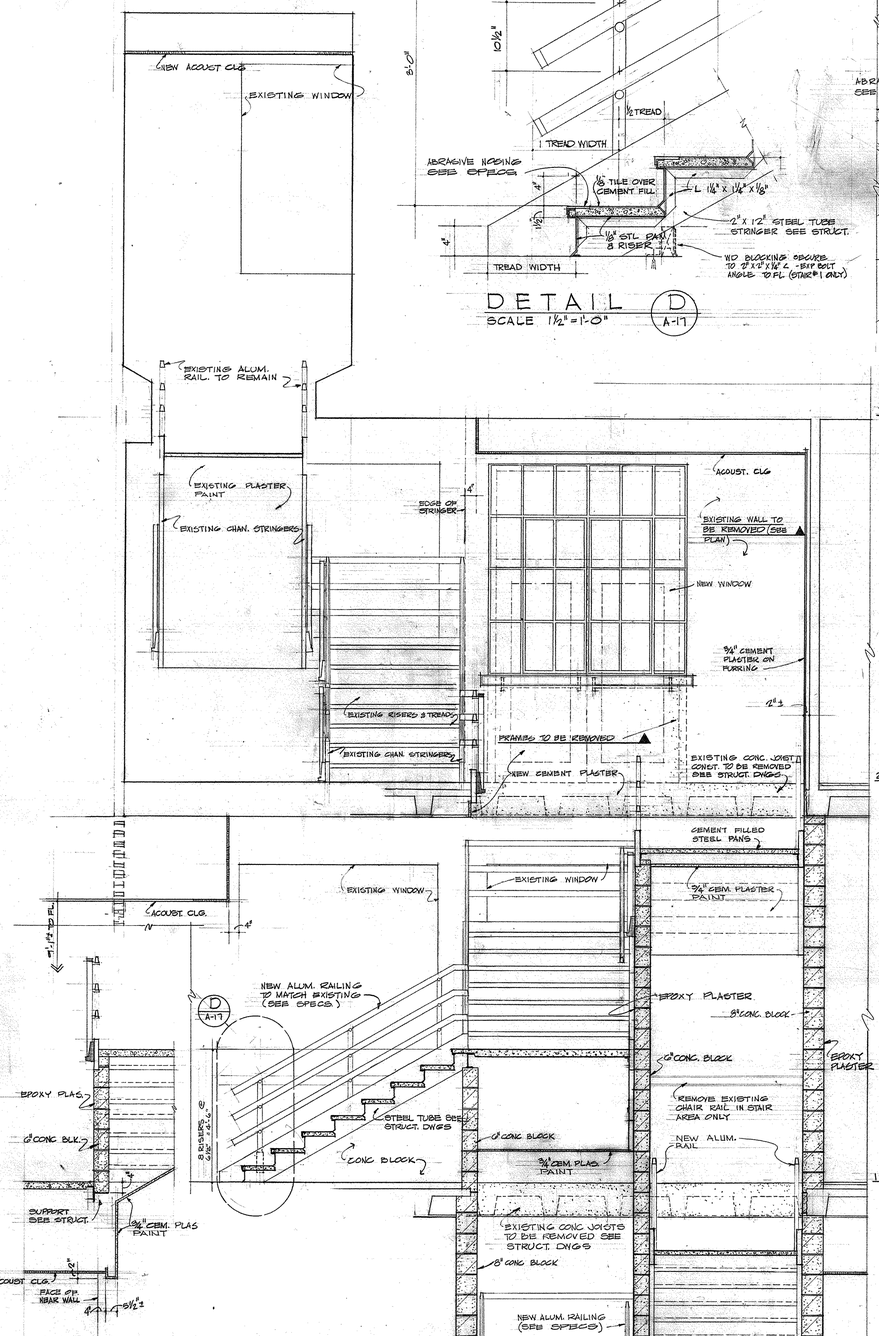

SECTION (A) A-17
SCALE ½"=1'-0"

SECTION (B) A-17
SCALE ½"=1'-0"

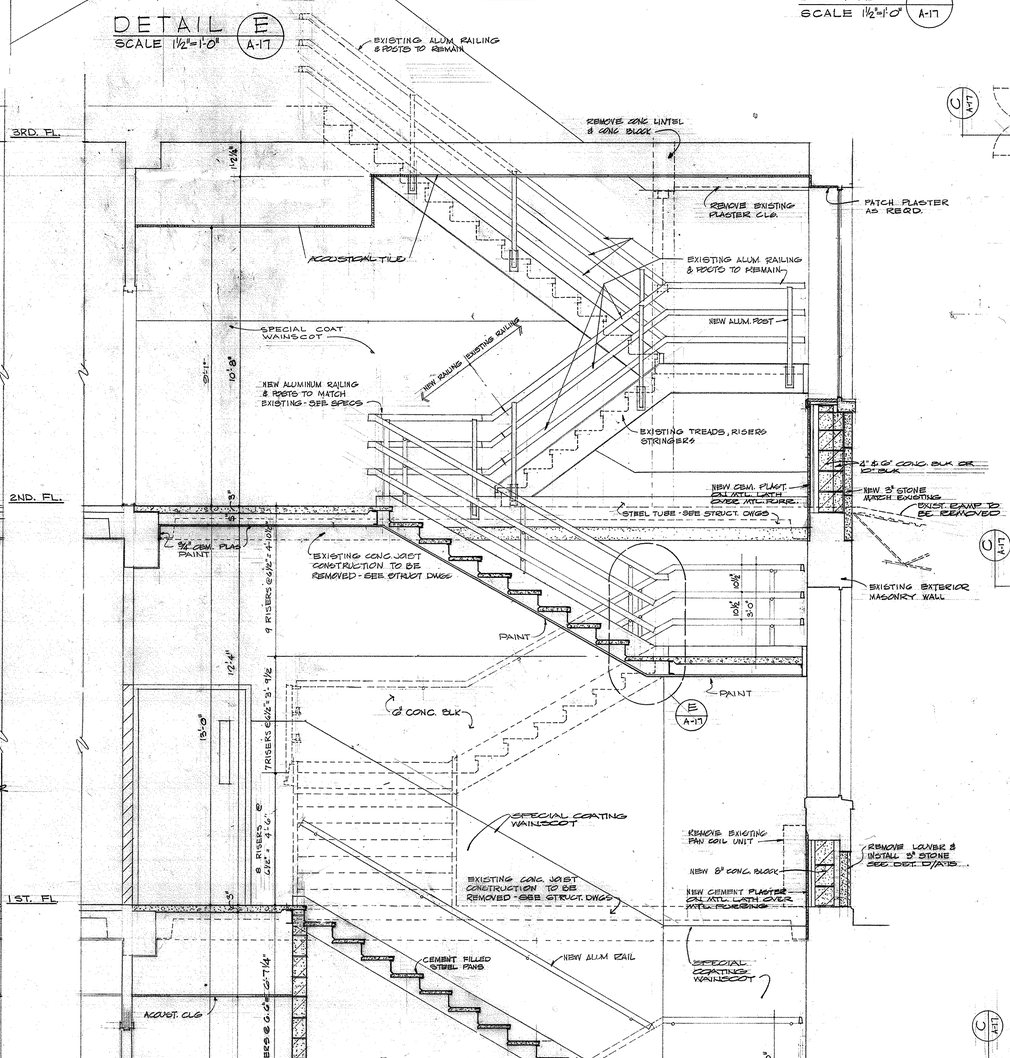

SECTION (C) A-17
SCALE ½"=1'-0"

NOTE!
CONC JOIST'S ARE SHOWN TO SHOW TYPE OF CONSTRUCTION ONLY AND ARE NOT VERIFIED

I certify that these are AS BUILT DRAWINGS to the best of my knowledge and belief.

FRANK D. CAIN, JR. REGISTERED No. 488 COMMONWEALTH OF KENTUCKY ARCHITECT

RENOVATION OF CHERRY HALL
WESTERN KENTUCKY UNIVERSITY
BOWLING GREEN, KENTUCKY

DRAWN F.D.C., R.H., B.F.	STAIR - 2 PLAN, SECTIONS & DETAIL	DATE 4-5-72
TRACED R.H., S.D.	FRANK D. CAIN JR., A. I. A. ARCHITECT BOWLING GREEN, KENTUCKY	SCALE AS NOTED
CHECKED F.D.C.		SPEC. NO. 7201
	COMMONWEALTH OF KENTUCKY DEPARTMENT OF FINANCE DIVISION OF ENGINEERING FRANKFORT, KENTUCKY	DRAWING NO. A-17 OF 22

APPROVED BY _____ AGENCY HEAD DATE APR 6 1972
APPROVED BY _____ CHIEF OF STAFF DATE 4/4/72

R-2361

ROOM FINISH SCHEDULE

BASEMENT PLAN

ROOM NO.	NAME	FLOOR	BASE	WALLS MAT'L	WALLS FINISH	CEILING MAT'L	CEILING FINISH	CEILING HGT	REMARKS = NOTES
7	CORRIDOR	RES. TILE①	DEM. PART.	DEM. PART.	PRE-FIN.	AC. TILE	PRE-FIN.	8'-0"	SEE NOTES - THIS SHEET ○
7-A	OFFICE	" " "	RUBB, D. P.	PLAST, D. P.	PRE-FIN, PNT	③ "	"	8'-0"	• INSULATION OVER CEILING FOR CEIL. PART. PAINT PLAST.
7-B	OFFICE	" " "	" " "	" " "	" " "	② "	"	"	" " " "
7-C	OFFICE	" " "	" " "	" " "	" " "	" "	"	"	" " " "
7-D	OFFICE	" " "	" " "	" " "	" " "	" "	"	"	" " " "
7-E	OFFICE	" " "	" " "	" " "	" " "	" "	"	"	" " " "
7-F	OFFICE	" " "	" " "	" " "	" " "	" "	"	"	" " " "
7-G	OFFICE	" " "	" " "	" " "	" " "	" "	"	"	" " " "
7-H	OFFICE	" " "	" " "	" " "	" " "	" "	"	"	" " " "
7-I	OFFICE	" " "	" " "	" " "	" " "	" "	"	"	" " " "
7-J	OFFICE	" " "	" " "	" " "	" " "	" "	"	"	" " " "
7-K	OFFICE	" " "	" " "	" " "	" " "	" "	"	"	" " " "
2	LOBBY	RES. TILE	SP. COAT.	BLK./PLST.	SP. COAT.	PLAST	PAINT	8'-4"	
2-A	OFFICE	" "	RUBB.	" "	PAINT	"	"	8'-0"	INSULATION OVER CEILING
2-B	OFFICE	" "	"	" "	"	"	"	"	" " " "
2-C	ELEV. MACH. RM.	CONCR.	—	" "	"	PLAST	PAINT	9'-8"±	
5 & A	OFFICE, & CORR	RES. TILE④	RUBB.	PLAST, D. P.	PRE-FIN, PNT	AC. TILE	PRE-FIN.	8'-0"	• INSULATION OVER CEILING
5-B	OFFICE	" " "	" " "	" " "	" " "	" "	"	"	" " " "
5-C	OFFICE	" " "	" " "	" " "	" " "	" "	"	"	" " " "
4	CLASSROOM	" " "	RUBBER	PLAST.	PAINT	PLAST	PAINT	9'-8"±	
5	CORRIDOR	" " "	RUBB. D.P.	PLAST, D.P.	PRE-FIN, PNT	AC TILE	PRE-FIN	8'-0"	• INSULATION OVER CEILING
3-A	OFFICE	" " "	" " "	" " "	" " "	" "	"	"	" " " "
3-B	OFFICE	" " "	" " "	" " "	" " "	" "	"	"	" " " "
3-C	OFFICE	" " "	" " "	" " "	" " "	" "	"	"	" " " "
3-D	OFFICE	" " "	" " "	" " "	" " "	" "	"	"	" " " "
3-E	OFFICE	" " "	" " "	" " "	" " "	" "	"	"	" " " "
3-F	OFFICE	" " "	" " "	" " "	" " "	" "	"	"	" " " "
6	HALL	" " "	RUBB.	PLAST	PAINT	" "	"	"	" " " "
6A	OFFICE	" " "	"	"	"	"	"	"	" " " "
• 6-B	OFFICE	" " "	"	"	"	"	"	"	" " " "
1	CLASSROOM	" " "	"	"	"	PLAST.	PAINT	9'-8"±	
8	STORAGE	CONCR.	—	"	"	"	"	"	" " "
9	OFFICE	RES. TILE⑤	RUBBER	"	"	AC TILE	PRE-FIN	8'-0"	
10	ELECT. VAULT	CONCR.	—	"	EXIST	PLAST	EXIST	9'-8"±	PATCH EXIST. PAINT
11	OFFICE	RES. TILE④	RUBB.	"	PAINT	AC. TILE	PRE-FIN	8'-0"	
12	STORAGE	CONCR.	—	"	"	PLAST	PAINT	9'-8"±	
13	OFFICE	RES. TILE④	RUBBER	"	"	AC. TILE	PRE-FIN	8'-0"	
14	OFFICE	" " "	" " "	BLOCK	"	" "	"	"	" " " "
14-A	JANITOR	EXIST.	EXIST	PLAST	"	PLAST	PAINT	9'-8"±	
14-B	CHASE	—	—	—	—	—	—	—	
15	CLASSROOM	RES. TILE④	RUBB.	PLAST.	PAINT	PLAST	PAINT	9'-8"±	
15-A	HALL	" " "	"	"	"	"	"	"	" " " "
16	HALL	" " "	"	BLOCK	"	AC TILE	PRE-FIN	8'-0"	• INSULATION OVER CEILING
16-A	OFFICE	" " "	"	"	"	" "	"	"	" " " "
16-B	OFFICE	" " "	"	PLAST/BLK	"	" "	"	"	" " " "
16-C	OFFICE	" " "	"	"	"	" "	"	"	" " " "
17	CLASSROOM	" " "	"	"	"	PLAST.	PAINT	9'-8"±	
18	CLASSROOM	" " "	"	"	"	"	"	"	" " " "
19	CLASSROOM	" " "	"	"	"	AC. TILE/EX	PRE-F/PNT	8'-0"±	SEE SECTION B/A-14
20	CORRIDOR	RES. TILE⑤	RUBB. D.P.	PLAST, D.P.	PRE-FIN/PNT	PLAST.	PAINT	8'-0"±	
20-A	OFFICE	" " "	" " "	" " "	" " "	" "	"	"	" " " "
20-B	OFFICE	" " "	" " "	" " "	" " "	" "	"	"	" " " "
20-C	OFFICE	" " "	" " "	" " "	" " "	" "	"	"	" " " "
20-D	OFFICE	" " "	" " "	" " "	" " "	" "	"	"	" " " "
20-E	OFFICE	" " "	" " "	" " "	" " "	" "	"	"	" " " "
20-F	OFFICE	" " "	" " "	" " "	" " "	" "	"	"	" " " "
20-G	OFFICE	" " "	" " "	" " "	" " "	" "	"	"	" " " "
20-H	OFFICE	" " "	" " "	" " "	" " "	" "	"	"	" " " "
20-I	STORAGE	" " "	" " "	" " "	" " "	" "	"	"	" " " "
20-J	STORAGE	" " "	" " "	" " "	" " "	" "	"	"	" " " "
20-K	STORAGE	" " "	RUBB.	PLAST	PAINT	" "	"	"	" " " "
21	AUDIO-VISUAL RM.	" " " ①	RUBB.	CER./PLAST	"	AC TILE	PRE-FIN	8'-6"	
22	CLASSROOM	" " " ①	RUBB./VINYL	" "	"	AC TILE	PRE-FIN	8'-6"	
23	CLASSROOM	" " " ①	" "	" "	"	" "	"	"	" " " "
24	SEMINAR	" " "	" "	" "	"	" "	"	"	" " " "
25	SEMINAR	" " "	" "	" "	"	" "	"	"	" " " "
26	CLASSROOM	" " "	" "	" "	"	" "	"	"	" " " "
27	SEMINAR/CONFERENCE	" " "	" "	" "	"	" "	"	"	" " " "
28	SEMINAR	" " "	" "	" "	"	" "	"	"	" " " "
29	SEMINAR	" " ④	RUBBER	BLK./PLAST.	PAINT	PLASTER	PAINT	9'-8"±	
30	OFFICE	" " ①	RUBB/DP	D.P./PLAST.	PREF/PNT.	AC. TILE	PRE-FIN	8'-0"	
31	OFFICE	" " ④	RUBB/D.P.	BLK/D. P.	PREF/PNT	AC. TILE	PRE-FIN	8'-0"	
32	EXIST. VAULT	EXIST	EXIST	PLAST	PAINT	PLAST.	PAINT	9'-?	
33	OFFICE	RES. TILE②	RUBB./DP.	PLAST/D.P.	PREF/PNT	AC. TILE	PRE-FIN	8'-0"	
34	OFFICE	" " "	" "	" "	" "	" "	"	"	" " " "
35	OFFICE	" " "	" "	" "	" "	" "	"	"	" " " "
36	OFFICE	" " "	" "	" "	" "	" "	"	"	" " " "
37	CORRIDOR	" " "	" "	" "	" "	" "	"	"	" " " "
37-A	CAMPUS SUB-STATION	CONCR	—	—	—	—	—	—	PATCH WORK
38	CORRIDOR	RES. TILE①	RUBB.	PLAST/BLK	• PAINT ⑥	AC. TILE	PRE-FIN	8'-0"	• 5'-0" SPECIAL CT. WAINSCOT ⑨ • PAINT CONC. BASE
39	CORRIDOR	" " "	EXIST II •	PLAST	" ⑥	" "	"	"	• 6'-0" SP. COAT WAINS. ⑤
40	HALL	PAINT	EXIST	"	PAINT •	" "	"	"	• 6'-0" SP. COAT WAINS. ⑤
40-A	WOMEN	"	"	"	" •	" "	"	"	
40-B	JANITOR	CONCR	"	"	PAINT	PLAST.	PAINT	9'-8"±	
40-C	STORAGE	"	"	"	"	"	"	"	
40-D	CHASE	—	—	—	—	—	—	—	
41	CORRIDOR	RES. TILE①	EX. CONCR.	PLAST	PAINT ⑥	AC TILE	PRE-FIN	8'-0"	• PAINT BASE
42	HALL	PAINT	EXIST	"	PAINT •	AC TILE	" "	8'-0"	• 6'-0" SP. COAT WAINS. ⑤
42-A	JANITOR	CONCR	"	"	PAINT	PLAST	PAINT	9'-8"±	
42-B	MEN	PAINT	"	"	PAINT •	AC, TILE	PRE-FIN	8'-0"	• 6'-0" SP. COAT WAINS. ⑤
43	CORRIDOR	RES. TILE①	EX. CONCR.	"	PAINT	" "	" "	"	• PAINT CONCR. BASE
44-A	STORAGE	CONCR.	—	"	"	PLAST	PAINT	9'-8"±	
45	CORRIDOR	RES. TILE①	6" RUBB	PLAST/BLK	" •	AC. TILE	PRE-FIN	8'-0"	• 6'-0" SP. COAT WAINS. ⑤
46	LOBBY	RES TILE⑥	"	PLAST	" •	" "	" "	8'-4"	• 6'-0" SP. COAT WAINS. ⑤
47	MECH. ROOM	CONCR	—	PLAST/BLK	"	INSUL.	—	9'-8"±	
48	ELECT. VAULT	"	—	" "	"	PLAST	PAINT	" "	
49	CHIMES EQUIP.	"	—	PLAST	—	"	—	" "	PATCH PAINT
50	AUDIO-VISUAL STG.	RES TILE①	RUBBER	PLAST/BLK	PAINT	"	PAINT	9'-8"±	
• 6-C	STORAGE	" " ④	"	PLAST	"	"	"	" "	
• 44	CORRIDOR	RES. TILE①	EX. CONCR.	PLAST/BLK	PAINT ⑥	AC TILE	PRE-FIN	8'-0"	• PAINT CONCR. BASE
5G	STORAGE	EXIST.	—	CONC.	CLEAN	EXIST.	CLEAN	—	PATCH WALLS & CLG.

FIRST FLOOR

ROOM NO.	NAME	FLOOR	BASE	WALLS MAT'L	WALLS FINISH	CEILING MAT'L	CEILING FINISH	CEILING HGT	REMARKS = NOTES
100	SECRETARY	CARPET	WOOD	PLAST	PAINT	AC TILE	PRE-FIN	8'-0"	
100-A	STORAGE	EXISTING	"	"	"	EXISTING	PAINT	11'-11"	
100-B	OFFICE	CARPET	"	"	"	AC TILE	PRE-FIN	8'-0"	
101	OFFICES	RES. TILE⑦	"	PLAST/WD •	PAINT	PLASTER	PAINT	11'-11"	• CLEAN WD. PART, PAINT PLAST.
102	CLASSROOM	" " "	"	PLAST	"	"	"	"	" "
103	CLASSROOM	" " "	"	"	"	"	"	"	" "
104	CLASSROOM	" " "	"	"	"	"	"	"	" "
105	CONFERENCE RM.	CARPET	RUBBER	PANEL •	PREFIN.	AC TILE	PRE-FIN	9'-0"	• TYPE 2
105-A	STORAGE	RES. TILE ⑦	RUBBER	PLAST.	PAINT	PLASTER	PAINT	11'-11"	
106	SEMINAR/CONFERENCE	RES. TILE ⑦	RUBBER	PANEL •	PREFIN.	AC TILE	PRE-FIN	9'-0"	• TYPE 2
107-A	HALL	REFINISH	WOOD	PLASTER	PAINT	" "	"	8'-0"	
107-B	HALL	"	"	"	"	" "	"	8'-0"	
107-D	STORAGE	EXISTING	"	"	"	PLAST	PAINT	11'-11"	
107-E	STORAGE	"	"	"	"	"	"	11'-11"	
107-F	STORAGE	"	"	"	"	"	"	11'-11"	
110-A	OFFICE	REFINISH	"	"	"	AC TILE	PRE-FIN	8'-0"	
110-B	OFFICE	"	"	"	"	" "	"	8'-6"	
110-C	OFFICE	"	"	"	"	" "	"	8'-0"	
111	OFFICE	"	"	"	"	" "	"	8'-0"	
112	OFFICE	"	"	"	"	" "	"	8'-0"	
113	OFFICE	"	"	"	"	" "	"	8'-0"	
114	OFFICE	"	"	"	"	" "	"	8'-0"	
115	OFFICE	"	"	"	"	" "	"	8'-0"	
116	OFFICE	"	"	"	"	" "	"	8'-0"	
117	OFFICE	"	"	"	"	" "	"	8'-0"	
118	OFFICE	"	"	"	"	" "	"	8'-0"	
119	CONCESSIONS	RES. TILE⑦	WD./RUBB	PLAST/BLK	"	" "	"	"	
120	CLASSROOM	" " "	WOOD	PLASTER •	"	PLASTER	PAINT	11'-11"	• PAINT BLOCK WALL
121	CLASSROOM	" " "	"	"	"	" "	"	11'-11"	
122	CLASSROOM	" " "	"	"	"	" "	"	11'-11"	
123	CLASSROOM	" " "	"	"	"	" "	"	11'-11"	
123-A	LOUNGE	CARPET	"	"	"	AC. TILE	PRE-FIN	8'-0"	• 6'-0" SP. COAT. WAINS. ⑤
123-B	FACULTY WOMEN	TERR. ⑥	TERRAZ.	PLASTER	PAINT •	AC. TILE	PRE-FIN	8'-0"	• 6'-0" SP. COAT. WAINS. ⑤
123-C	HALL	" "	"	"	" •	" "	"	8'-0"	• 6'-0" SP. COAT. WAINS. ⑤
123-D	MEN	" "	"	"	" •	" "	"	8'-0"	• 6'-0" SP. COAT. WAINS. ⑤
123-E	JANITOR	CONCR.	—	"	PAINT	PLAST	PAINT	11'-11"	
123-F	CHASE	—	—	—	—	—	—	—	
124	SEMINAR/CLASSROOM	RES. TILE⑦	WOOD	PLASTER	PAINT	PLASTER	PAINT	11'-11"	
125	LECTURE RM.	• CARPET ①	"	"	"	"	"	11'-11"	• NEW WOOD SUB-FLOOR
125-A	STORAGE	• RES TILE	"	"	"	"	"	10'-0"±	• RESILIENT TILE OVER 1/2" UNDERLAYMENT
126	CLASSROOM	RES TILE⑦	"	"	"	"	"	11'-11"	
126-A	STORAGE	" "	"	"	"	"	"	11'-11"	
127	CLASSROOM	" "	"	"	"	"	"	11'-11"	
128	OFFICE	REFINISH	"	"	"	AC TILE	PRE-FIN	8'-0"	
129	OFFICE	"	"	"	"	"	"	8'-0"	
130	OFFICE	"	"	"	"	"	"	8'-0"	
131	HALL	"	"	"	"	"	"	8'-0"	
131-A	OFFICE	"	"	"	"	"	"	8'-0"	
132	OFFICE	"	"	"	"	"	"	8'-0"	
133-A	OFFICE	"	"	"	"	"	"	8'-0"	
133-B	STORAGE	EXIST.	"	"	"	PLAST.	PAINT	11'-11"	
134	RECEPTIONIST	CARPET	WD/D.P	PLAST/D.P	PREF/PNT	AC TILE	PRE-FIN	9'-1"±	• INSULATION OVER CEILING
134-A	GRAD. ADVISOR	"	"	"	"	" "	"	9'-1"±	• " " "
135	RECEPTIONIST	"	"	PLAST	PAINT	" "	"	9'-1"±	
135-A	WORK ROOM	"	"	PLAST/DP	PREF/PNT	" "	"	9'-1"±	• INSULATION OVER CEILING
135-B	DEPT. HEAD	"	WOOD	PLAST	PAINT	AC TILE	PRE-FIN	9'-1"±	
135-C	CONFERENCE	"	WD/D.P.	PLAST/DP.	PREF/PNT	" "	"	9'-1"±	• INSULATION OVER CEILING
135-E	CLOSET	"	WD/DP.	"	"	" "	"	9'-1"±	
107	OFFICE	EX. RES. T.	WOOD	PLAST.	PAINT	PLAST	PAINT	11'-11"	
108	OFFICE	" "	WD/D.P	PLAST/DP	PREF/PNT	"	"	11'-11"	
109	HALL	" "	"	"	"	AC TILE	PRE-FIN	9'-0"	
109-A	OFFICE	" "	"	"	"	PLASTER	PAINT	11'-11"	
109-B	OFFICE	RES TILE•	WOOD	PLAST	PAINT	AC TILE	PRE-FIN	9'-0"	• LAY OVER EX. TO MATCH #138
109-C	OFFICE	EX RES TILE	WD/D.P.	PLAST/DP	PREF/PNT	PLASTER	PAINT	11'-11"	
109-D	OFFICE	" "	"	"	"	"	PLASTER	PAINT	11'-11"
109-E	OFFICE	RES TILE•	WOOD	PLASTER	PAINT	AC TILE	PRE-FIN	9'-0"	• LAY OVER WD. TO MATCH #138
109-F	OFFICE	EX RES TIL	"	"	"	"	"	11'-11"	
138-G	VAULT	CONCR	—	"	"	"	"	11'-11"	
139	HALL	TERR. ⑥	TERR	"	" •	AC TILE	PRE-FIN	8'-0"	• 6'-0" SP COAT WAINS. ⑤
139-A	JANITOR	CONCR	WOOD	"	PAINT	PLAST	PAINT	11'-11"	
139-B	WOMEN	TERR ⑥	TERR	"	" •	AC TILE	PRE-FIN	8'-0"	• 6'-0" SP COAT WAINS. ⑤
140	JANITOR	CONCR	WOOD	"	"	PLAST	PAINT	11'-11"	
140-A	CHASE	—	—	—	—	—	—	—	
141	CORRIDOR	RES. TILE①	MARBLE	PLAST/MARB	⑤ PAINT •	AC. TILE	PRE-FIN	9'-1"±	• SEE DTLS. FOR MARBLE WAINS.
142	CORRIDOR	" "	"	"	" "	" "	"	9'-1"±	" " " " "
143	CORRIDOR	" "	"	"	" "	" "	"	9'-1"±	" " " " "
144	CORRIDOR	" "	"	"	" "	" "	"	9'-1"±	" " " " "
145	CORRIDOR	" "	"	"	" "	" "	"	9'-1"±	" " " " "
146	CORRIDOR	" "	"	"	" "	" "	"	9'-1"±	" " " " "
147	LOBBY	GL. Q. TILE •	FIXED/CT.	CERT./PANEL TYPE 1	PRE FIN ••	AC. TILE #2	24X24 REC.	9'-1"±	• SEE SPECS. •• SEE DTLS
148	LOBBY	GL. Q. TILE •	MARBLE	PLAST/MAR	PAINT ••	PLAST	PAINT	11'-11"	• " " " •• " " "
148-A	LOBBY	" " •	STONE/CT.	CER/STONE	PREF. ••	AC. TILE #2	24X24 RECES	10'-4"S	• " " " •• " " "
149	ENTRY	" " •	MARBLE	PLAST/MAR	PAINT ••	PLAST	PAINT	11'-11"±	• " " " •• " " "

ROOM FINISH SCHEDULE NOTES

1. Over existing tile, patch and machine sand. (See Specs.)
2. Demountable Partitions are prefinished vinyl with base included. Paint plaster and install 4" rubber base.
3. Acoustical Tile shall be 2' X 4' lay-in, unless noted No. 2, which shall be 24" X 24", with recessed grid.
4. Resilient Tile over concrete; clean, patch, and light sand as required for smooth surface.
5. Remove remaining existing resilient tile and machine sand. Clean, patch, and provide smooth surface.
6. New Block Fire Walls in corridors receive Special Coating, both sides.
7. Resilient Tile on Felt Underlayment.
8. Clean, repair, regrind, and seal terrazzo.
9. Remove existing enamel and paint from Keene cement before applying special coating. Special coating to be applied in accordance with manufacturer's recommendations.
10. For stair 4 and stair 5 clean existing marble, treads, risers, trim, and wainscot. Remove from each tread, the two 3M Company stick-on abrasive strips and install new equal 3M Company abrasive strips or equal. Clean existing metal balusters, but do not paint. Replace missing wood pinnacles and refinish wood hand rails.

EXISTING CHALK BOARDS AND TACK BOARDS: Refer to the details and partial elevations of the existing chalk boards taken from the original Drawings, for the length and mounting height of chalk boards. The dimensions, 3'0" or 4'0" shown on the Plans by ECS refer to the height of the chalkboard material. Many tack boards of different types, have been added and Contractor must verify size & location.

NOTE: Patch plaster jambs at all windows as necessary to receive scheduled finish.

NOTE: See Sheet A-13 for details of furred areas at window heads in rooms receiving acoustical tile ceilings.

I certify that these are AS BUILT DRAWINGS to the best of my knowledge and belief.

FRANK D. CAIN JR. REGISTERED No. 488 COMMONWEALTH OF KENTUCKY ARCHITECT

RENOVATION OF CHERRY HALL
WESTERN KENTUCKY UNIVERSITY
BOWLING GREEN, KENTUCKY

DRAWN FDC	ROOM FINISH SCHEDULE	DATE 4/5/72
TRACED SKD	FRANK D. CAIN JR., A. I. A. ARCHITECT BOWLING GREEN, KENTUCKY	SCALE AS NOTED
CHECKED		SPEC. NO. 7201
	COMMONWEALTH OF KENTUCKY DEPARTMENT OF FINANCE DIVISION OF ENGINEERING FRANKFORT, KENTUCKY	DRAWING NO. A-18 OF 22

APPROVED BY _____ AGENCY HEAD DATE APR 6 1972
APPROVED BY _____ CHIEF OF STAFF DATE 4/6/72

R-2362

ROOM FINISH SCHEDULE

SECOND FLOOR

ROOM NO.	ROOM NAME	FLOOR	BASE	WALLS MAT'L	WALLS FINISH	CEILING MAT'L	CEILING FINISH	CEILING HGT	REMARKS — NOTES
200	WAITING	CARPET	WOOD	PLAST.	PAINT	AC. TILE	PRE-FIN	9'-1"±	
200-A	SECRETARY	"	"	"	"	"	"	9'-1"±	
201	SECRETARY	"	"	"	"	"	"	9'-1"±	
201-A	DEPT. HEAD	"	"	"	"	"	"	9'-1"±	
202	CLASSROOM	RES. TILE ⑦	"	"	"	PLASTER	PAINT	11'-11"	
203	HALL	" " "	"	BLOCK	"	AC. TILE	PRE-FIN	8'-0"	
203-A	CLASSROOM	" " "	"	PLAST/BLK	"	PLASTER	PAINT	11'-11"	
203-B	SEMINAR	CARPET •	"	PANEL •	PREFIN.	"	"	11'-11"	• TYPE 2 PANELING
204	CLASSROOM	RES. TILE ⑦	"	PLASTER	"	"	"	11'-11"	
205	WAITING	REFINISH	"	"	"	AC. TILE	PRE-FIN	8'-0"	
206	OFFICE	"	"	"	"	"	"	8'-0"	
206-A	STORAGE	EXISTING	"	"	"	PLASTER	PAINT	11'-11"	
207	OFFICE	REFINISH	"	"	"	AC TILE	PRE-FIN	8'-0"	
208	OFFICE	"	"	"	"	"	"	8'-0"	" "
208-A	STORAGE	EXISTING	"	"	"	PLASTER	PAINT	11'-11"	
209	CLASSROOM	RES. TILE ⑦	"	"	"	"	"	11'-11"	
210	CLASSROOM	CARPET	"	"	"	"	"	11'-11"	
211	CLASSROOM	RES. TILE ⑦	"	"	"	"	"	11'-11"	
212	OFFICE	REFINISH	"	"	"	AC TILE	PRE-FIN	8'-0"	
213	WAITING	"	"	"	"	"	"	8'-0"	
213-A	MECHANICAL	—	—	—	—	—	—	—	
213-B	STORAGE	EXISTING	WOOD	PLAST	PAINT	PLAST	PAINT	11'-11"	
214-A	OFFICE	REFINISH	"	"	"	AC TILE	PRE-FIN	8'-0"	
214-B	OFFICE	"	"	"	"	"	"	8'-0"	
215	CLASSROOM	RES. TILE ⑦	"	"	"	PLASTER	PAINT	11'-11"	
215-A	OFFICE	REFINISH	"	"	"	AC. TILE	PRE-FIN	8'-0"	
216	WAITING	"	"	"	"	"	"	8'-0"	
216-A	HALL	"	"	"	"	"	"	8'-0"	
216-B	STORAGE	EXISTING	"	"	"	PLASTER	PAINT	11'-11"	
217	OFFICE	REFINISH	"	"	"	AC TILE	PRE-FIN	8'-0"	
218	LIBRARY WORK RM.	"	"	"	"	"	"	8'-0"	
219	OFFICE	"	"	"	"	"	"	8'-0"	
220	CLASSROOM	RES TILE ⑦	"	"	"	PLAST	PAINT	11'-11"	
221	CLASSROOM	" " "	"	"	"	"	"	11'-11"	
222	SEMINAR	" " "	"	"	"	AC TILE	PRE-FIN	9'-0"	
223	WAITING	REFINISH	"	"	"	"	"	8'-0"	
223-A	OFFICE	"	"	"	"	"	"	8'-0"	
223-B	OFFICE	"	"	"	"	"	"	8'-0"	
223-C	STORAGE	EXISTING	"	"	"	PLASTER	PAINT	11'-11"	
223-D	STORAGE	"	"	"	"	"	"	11'-11"	
224	WAITING	RES. TILE ⑦	WD/D.P	PLAST/DP	PREFIN/PNT	AC TILE	PRE-FIN	8'-0"	•• INSULATION OVER CEILING
224-A	OFFICE	" " "	" "	" "	" "	AC TILE	PRE-FIN	8'-0"	•• INSULATION OVER CEILING
224-B	OFFICE	" " "	" "	" "	" "	" ••	" "	8'-0"	•• " " "
224-C	OFFICE	" " "	" "	" "	" "	" ••	" "	8'-0"	•• " " "
224-D	OFFICE	" " "	" "	" "	" "	" ••	" "	8'-0"	•• " " "
225/226A	GRAD. ASST.	" " "	WOOD	PLASTER	PAINT	" "	" "	9'-1"±	
226	GRAD. ASST.	" " "	" "	"	"	" "	" "	9'-1"±	PAINT BLOCK
227	THEATER / AUD.-VIS.	CARPET •	"	"	"	PLASTER	PAINT	11'-11"	• NEW CONC. TOPPING
227-A	STORAGE	RES. TILE ⑦	"	"	"	"	"	9'-7	
228	CLASSROOM	" " "	"	"	"	"	"	11'-11"	
228-A	STORAGE	EXISTING	"	"	"	"	"	11'-11"	
229	SEMINAR	RES. TILE ⑦	"	"	"	"	"	11'-11"	
230	CORRIDOR	REFINISH	"	"	"	AC. TILE	PRE-FIN	8'-0"	
230-A	OFFICE	" "	"	"	"	" "	" "	8'-0"	
230-B	OFFICE	"	"	"	"	" "	" "	8'-0"	
230-C	LIBRARY WORK RM.	"	"	"	"	" "	" "	8'-0"	
230-D	OFFICE	"	"	"	"	" "	" "	8'-0"	
230-E	OFFICE	"	"	"	"	" "	" "	8'-0"	
231	OFFICE	"	"	"	"	" "	" "	8'-0"	
232	OFFICE	"	"	"	"	" "	" "	8'-0"	
233	OFFICE	"	"	"	"	" "	" "	8'-0"	
234	CORRIDOR	"	"	"	"	" "	" "	8'-0"	
235	STORAGE	EXISTING	"	"	"	PLASTER	PAINT	11'-11"	
236	OFFICE	REFINISH	"	"	"	AC. TILE	PRE-FIN	8'-0"	
237	OFFICE	"	"	"	"	" "	" "	8'-0"	
238	OFFICE	"	"	"	"	" "	" "	8'-0"	
239	CLASSROOM	RES. TILE ⑦	"	"	"	PLASTER	PAINT	11'-11"	
240	SECRETARY	CARPET	"	"	"	AC. TILE	PRE-FIN	9'-1"±	
240-A	DIR. GRAD. STUDIES	"	"	"	"	"	"	9'-1"±	
240-A	OFFICE	RES. TILE ⑦	WOOD	BLOCK	PANEL •	"	"	8'-0"	• PANEL - TYPE 1, FURR WALL
240-B	OFFICE	" " "	"	"	"	"	"	8'-0"	" " " " " "
240-C	OFFICE	" " "	"	"	"	"	"	8'-0"	• " " " " "
240-D	OFFICE	" " "	"	"	"	"	"	8'-0"	• " " " " "
245	CORRIDOR	RES TILE ①	MARBLE	PLAST/MAR.	PAINT ⑥	"	"	9'-1"±	• SEE DTL'S. FOR MARBLE WAINS.
246	HALL	TERR ⑧	TERR.	PLASTER	PAINT •	"	"	8'-0"	• 6'-0" SP COAT WAINS ⑤
246-A	WOMEN	" ⑧	"	"	" •	"	"	8'-0"	• " " " " " ⑤
246-B	JANITOR	EXISTING	WOOD	"	PAINT	PLAST.	PAINT	11'-11"	
246-C	JANITOR	"	"	"	"	"	"	11'-11"	
246-D	LOUNGE	CARPET	"	"	"	AC. TILE	PRE-FIN.	8'-0"	
247	CORRIDOR	RES TILE ①	MARBLE	PLAST/MAR.	PAINT ⑥	AC TILE	PRE-FIN	9'-1"±	• SEE DTLS FOR MARBLE WAINS
248	CORRIDOR	"	"	" "	" ⑥	" "	" "	9'-1"±	" " " " "
249	CORRIDOR	RES TILE ⑦	SP COAT	BLOCK	SP.COAT	" "	" "	8'-0"	
250	CORRIDOR	RES TILE ①	MARBLE	PLAST/MAR.	PAINT ⑥	" "	" "	9'-1"±	• SEE DTLS FOR MARBLE WAINS
251	CORRIDOR	" " "	"	" "	" ⑥	" "	" "	" "	• " " " " " ⑥
252	HALL	TERR.	TERR.	PLASTER	PAINT •	" "	" "	8'-0"	• 6'-0" SP COAT WAINS ⑤
252-A	MEN	"	"	"	" •	" "	" "	8'-0"	• " " " " " ⑤
252-B	JANITOR	EXISTING	WOOD	"	PAINT	PLAST	PAINT	11'-11"	
252-C	CHASE	—	—	—	—	—	—	—	
246E	FACULTY MEN	TERRAZZO	TERR.	PLASTER	PAINT	AC. TILE	PRE-FIN.	8'-0"	• 6'-0" SP. COAT. WAINS ⑤
249A	CORRIDOR	RES. TILE ①	MARBLE	PLAST/MAR.	PAINT ⑥	"	"	"	• SEE DTLS. FOR MAR. WAINS.

THIRD FLOOR

ROOM NO.	ROOM NAME	FLOOR	BASE	WALLS MAT'L	WALLS FINISH	CEILING MAT'L	CEILING FINISH	CEILING HGT	REMARKS — NOTES
300	SECRETARY	CARPET	WD/D.P	PLAST/D.P	PREFIN/PNT	AC. TILE •	PRE-FIN	9'-1"	• INSULATION OVER CEILING
300-A	SECRETARY	"	" "	" "	" "	" " •	" "	9'-1"	• " " " "
300-B	SEMINAR/CONFERENCE	"	" "	" "	" "	" " •	" "	9'-1"	• " " " "
300-C	OFFICE	"	" "	" "	" "	" " •	" "	9'-1"	• " " " "
300-D	OFFICE	"	" "	" "	" "	" " •	" "	9'-1"	• " " " "
301	CLASSROOM	RES. TILE ⑦	WOOD	PLASTER	PAINT	PLASTER	PAINT	12'-0"	• LEVEL EX. FL. BEFORE LIND'LYM
301-A	STORAGE	" " "	"	"	"	"	"	12'-0"	• " " " " "
302	CLASSROOM	" " "	"	"	"	"	"	12'-0"	• " " " " "
302-A	STORAGE	EXISTING	"	"	"	"	"	12'-0"	
303	CLASSROOM	RES TILE ⑦	"	"	"	"	"	12'-0"	
303-A	STORAGE	EXISTING	"	"	"	"	"	12'0"	
304	CLASSROOM	RES. TILE ⑦	"	"	"	"	"	12'-0"	
305	CLASSROOM	" " "	"	"	"	"	"	12'-0"	
306	OFFICE	" " "	"	PLAST.	" "	AC TILE	PREFIN	8'-0"	
307	HALL	" "	"	PLAST/BLK	PAINT	" "	"	9'-0"	
307-A	CLASSROOM	" " "	"	"	"	PLAST	PAINT	12'0"	
308	SECRETARY	" " "	"	"	PANEL	AC. TILE	PRE-FIN	8'-0"	TYPE 2 PANEL - FURR
308-A	OFFICE	" " "	"	"	"	" "	" "	8'0"	" " " "
309	CLASSROOM	" " "	"	PLASTER	PAINT	PLASTER	PAINT	12'-0"	
310	OFFICE	" " "	"	"	"	AC TILE	PRE FIN	8'0"	
311	OFFICE	" " "	"	"	"	" "	" "	"	
312-A	CHASE	—	—	—	—	—	—	—	
312-B	STORAGE	EXISTING	WOOD	PLASTER	PAINT	PLASTER	PAINT	12'0"	
313	CLASSROOM	RES. TILE ⑦	"	"	"	"	"	12'0"	
314	OFFICE	" " "	"	"	"	AC TILE	PRE FIN	8'0"	
315	SEMINAR	" " "	"	"	"	AC TILE	PRE-FIN	9'0"	
316	SEMINAR	" " "	"	"	"	"	"	12'0"	
317	OFFICE	" " "	"	PLAST/BLK	PANEL •	AC TILE	PRE-FIN	8'-0"	• TYPE 2 PANEL FURR
317-A	CORROIDOR	" " "	SP COAT	BLK	SP COAT	" "	" "	8'-0"	
318	OFFICE	" " "	WOOD	PLAST/BLK	PANEL •	" "	" "	8'-0"	• TYPE 2 PANEL FURR
318-A	OFFICE	" " "	"	" "	" •	" "	" "	8'-0"	• " " " "
318-B	OFFICE	" " "	"	" "	" •	" "	" "	8'-0"	• " " " "
318-C	STORAGE	EXISTING	"	PLAST	PAINT	PLAST	PAINT	12'-0"	
319	WAITING	REFINISH	"	"	"	AC TILE	PRE-FIN	8'-0"	
319-A	OFFICE	"	"	"	"	" "	"	8'-0"	
319-B	OFFICE	"	"	"	"	" "	"	8'-0"	
319-C	OFFICE	"	"	"	"	" "	"	8'-0"	
319-D	STORAGE	EXISTING	"	"	"	PLAST	PAINT	12'-0"	
319-E	STORAGE	"	"	"	"	"	"	12'-0"	
320	CLASSROOM	RES TILE ⑦	"	"	"	PLASTER	"	12'-0"	
321	OFFICE	" " "	"	"	"	AC. TILE	PRE-FIN	8'-0"	
322	OFFICE	" " "	"	"	"	" "	" "	8'-0"	
323	HALL	TERR	TERR ⑤	"	PAINT •	" "	" "	8'-0"	• 6'-0" SP COAT WAINS. ⑤
323-A	MEN	"	" ⑤	"	" •	" "	" "	8'-0"	• " " " " " ⑤
323-B	JANITOR	EXISTING	WOOD	PLASTER •	PAINT	PLASTER	PAINT	12'-0"	• PATCH PLASTER
323-C	CHASE	—	—	—	—	—	—	—	
324	CLASSROOM	RES TILE ⑦	WOOD	PLASTER	PAINT	PLASTER	PAINT	12'-0"	
325	CLASSROOM	" " "	"	"	"	"	"	12'-0"	
326	CORRIDOR	RES TILE ①	MARBLE	PLAST/MAR •	PAINT ⑥	AC TILE	PREFIN.	9'-1"	• SEE DTLS FOR MARBLE WAINS
327	CORRIDOR	" " "	"	"	" ⑥	" "	"	9'-1"	• " " " " "
328	CORRIDOR	" " "	"	"	" ⑥	" "	"	9'-1"	• " " " " "
329	CLOSET	CONCR.		PLAST/BLK	PAINT	PLASTER	PAINT	12'-0"	
330	SPIRAL STAIRS	EXISTING	WOOD	PLAST/BLK	PAINT	PLASTER	PAINT	—	• PAINT SPIRAL STAIRS
331	HALL	TERR ⑧	TERR	PLASTER	PAINT •	AC TILE	PREFIN	8'-0"	• 6'-0" SP COAT WAINS. ⑤
331-A	WOMEN	TERR. ⑧	TERR	"	" •	" "	" "	8'-0"	• " " " " " ⑤
332	JANITOR	EXISTING	WOOD	PLASTER	PAINT	PLASTER	PAINT	12'-0"	
332-A	CHASE	—	—	—	—	—	—	—	
334	FAN ROOM	CONCR.	NONE	MTL.	PAINT •	MTL.	PAINT	SEE DTL.	• PAINT STRUCT. STEEL
300-E	LOUNGE	CARPET	WD/DP.	PLAST/DP.	PREF./PNT.	AC. TILE •	PREFIN.	9'-1"±	• INSULATION OVER CEILING
306-A	HALL	RES. TILE ⑦	WOOD	PLASTER	PAINT	"	"	8'0"	
328-A	CORRIDOR	RES. TILE ①	MARBLE	PLAST/MAR •	PAINT ⑥	AC. TILE	PREFIN.	9'-1"±	• SEE DTLS. FOR MAR. WAINS.
401	FAN ROOM	CONCR.	NONE	MTL.	PAINT •	MTL.	PAINT	SEE DTL.	• PAINT STRUCT. STEEL
331D	JANITOR	EXISTING	EXISTING	PLASTER	PAINT	PLASTER	PAINT	12'-0"	
	STAIR # 1	RES. TILE	SP. COAT.	BLK/PLAST.	• PAINT	PLAST./C.T.	PNT./PREF.	VARIES	• 6'-0 SP COAT. WAINS.
	STAIR # 2	" "	" "	" "	• "	" "	" "	"	• " " " "
	STAIR # 3	RES. TILE ••	" "	PLASTER	• "	PLASTER.	PAINT	"	•• 6'-0" SP COAT WAINS •• RUBB. TREADS/PNT. RISERS
	STAIR # 4	MARBLE ⑥	MARBLE	MARB/PLAST	CLEAN/PNT.	PLASTER	PAINT	"	• CLEAN MARBLE
	STAIR # 5	" ⑥	"	"	"	"	"	"	• CLEAN MARBLE

NOTE: Patch plaster jambs at all windows as necessary to receive scheduled finish.

tify that these are AS BUILT.
DRA... to the best of my knowledge
...d belief.

FRANK D. CAIN, JR. REGISTERED No. 488 COMMONWEALTH OF KENTUCKY ARCHITECT

RENOVATION OF CHERRY HALL
WESTERN KENTUCKY UNIVERSITY
BOWLING GREEN, KENTUCKY

DRAWN FDC	ROOM FINISH SCHEDULE	DATE 4/5/72
TRACED SKD	FRANK D. CAIN JR., A. I. A. ARCHITECT, BOWLING GREEN, KENTUCKY	SCALE AS NOTED
CHECKED		SPEC. NO. 7201
	COMMONWEALTH OF KENTUCKY DEPARTMENT OF FINANCE DIVISION OF ENGINEERING FRANKFORT, KENTUCKY	DRAWING NO. A-19 OF 22

APPROVED BY _____ AGENCY HEAD DATE APR 6 1972
APPROVED BY _____ CHIEF OF STAFF DATE 4/6/72

R2363

ROOF REPLACEMENT TO CHEERY HALL

WESTERN KENTUCKY UNIVERSITY

BOWLING GREEN, KY.

COMMONWEALTH OF KENTUCKY

FINANCE & ADMINISTRATION CABINET

DEPT FOR FACILITIES MANAGEMENT

DIVISION OF ENGINEERING

FRANKFORT, KY

ENGINEERING FILE NO. R-202

ARCHITECT JAMES E DENTON PSC
MADISONVILLE, KY

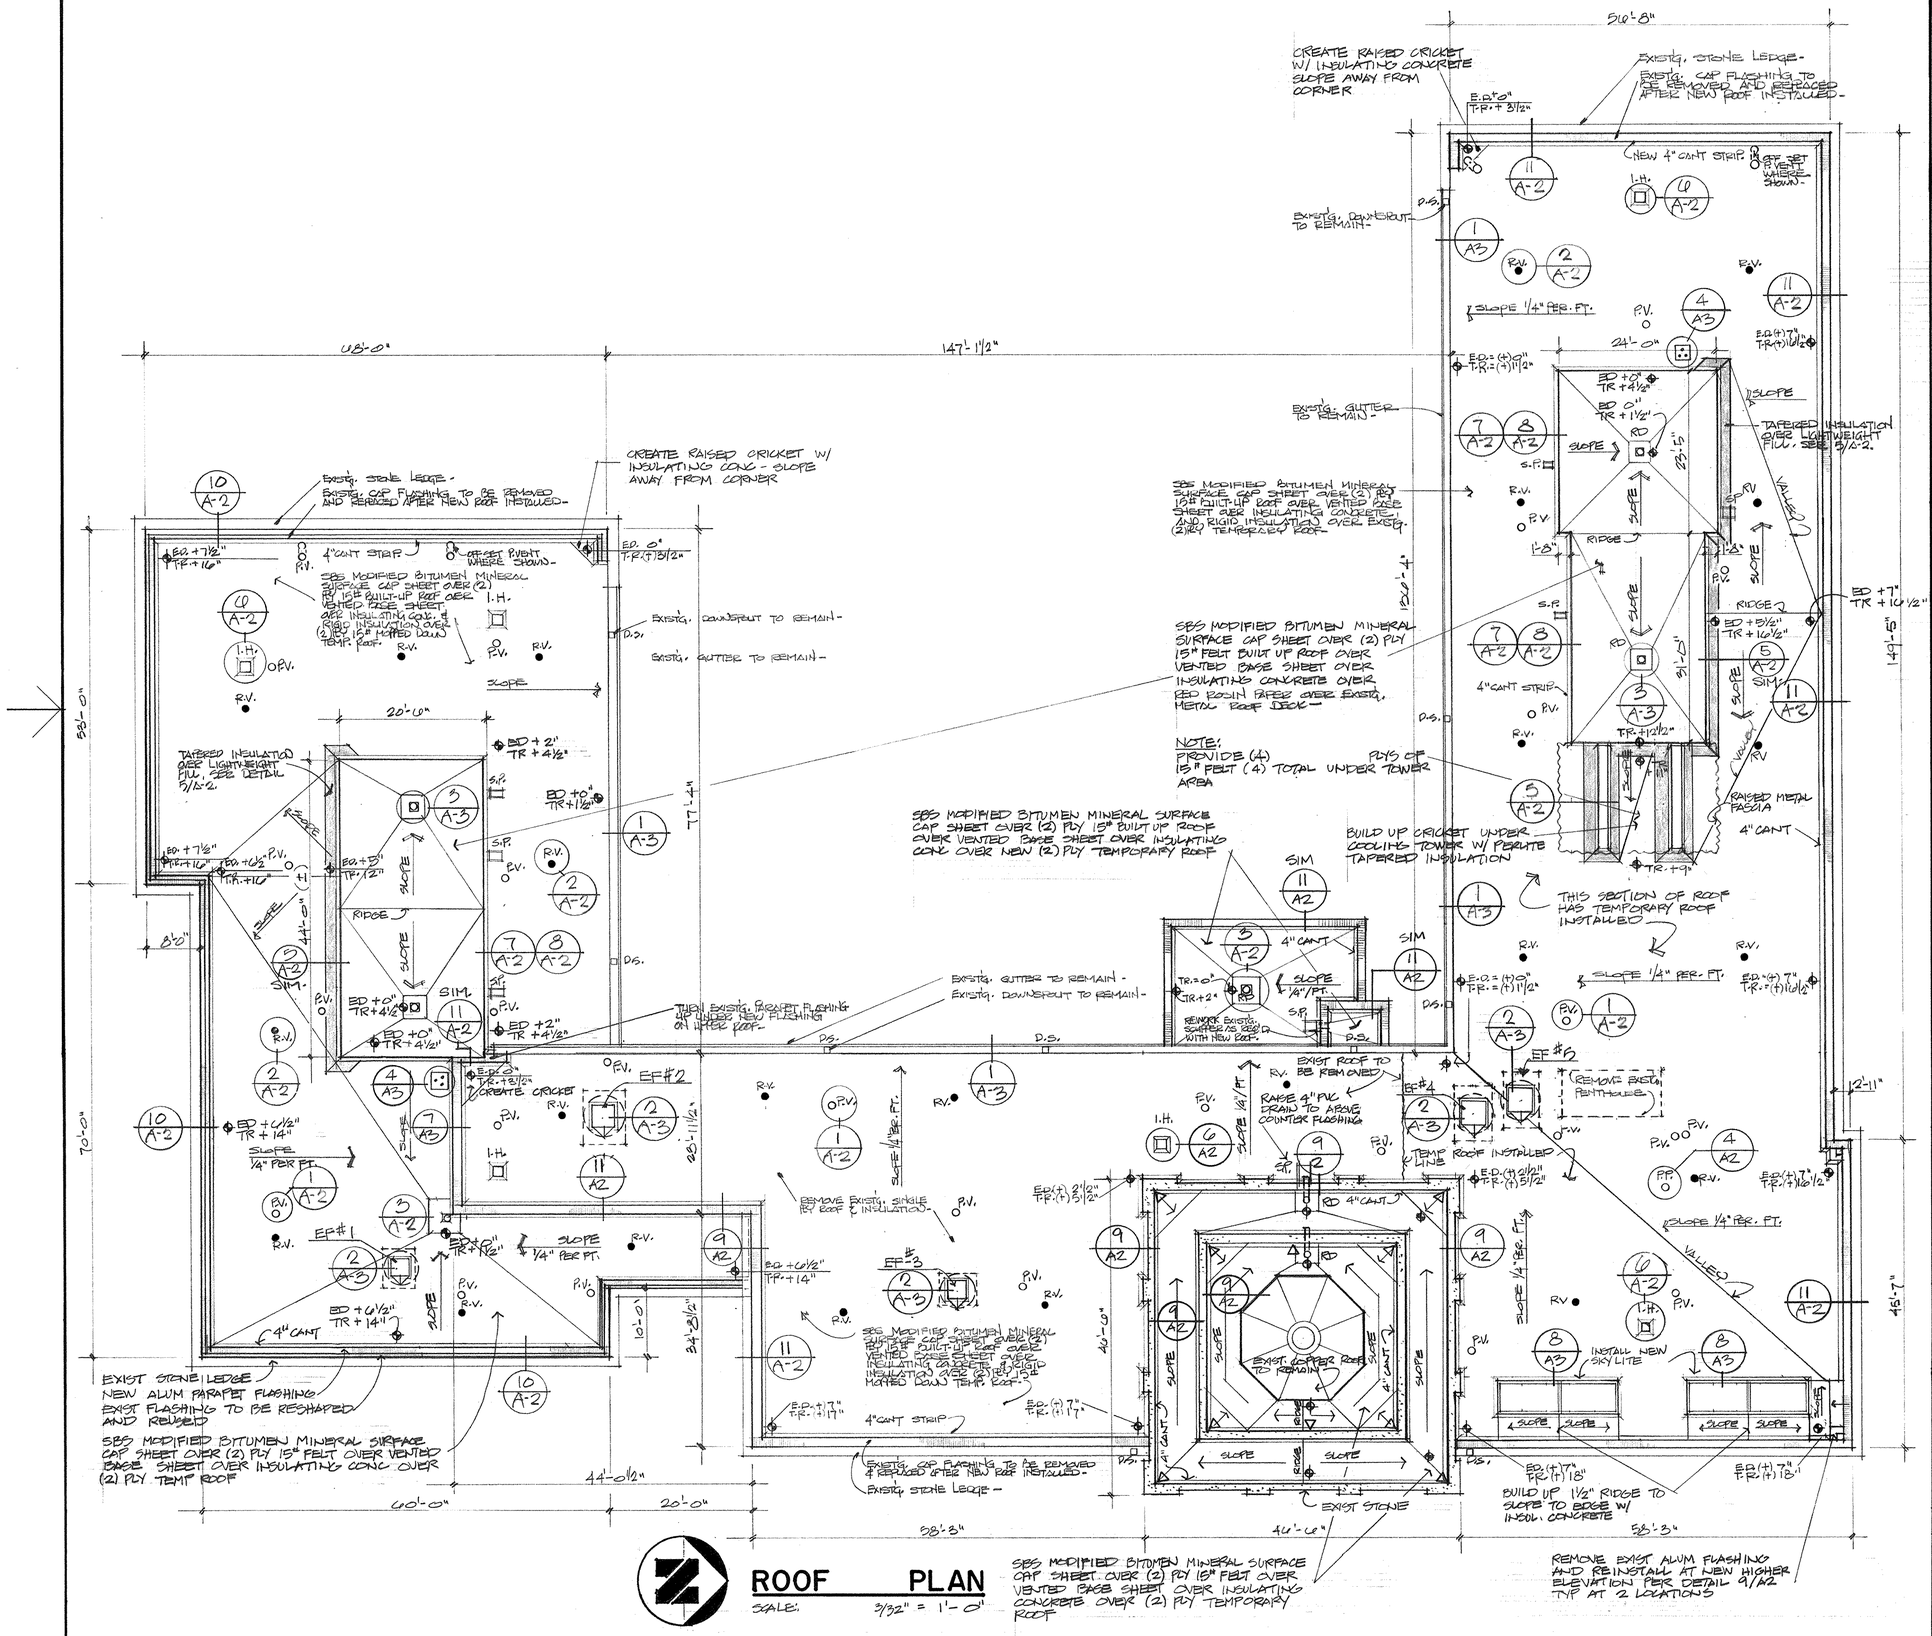

ROOF PLAN

SCALE: 3/32" = 1'-0"

SYMBOL LEGEND

- E.D. ELEVATION OF EXISTING CONCRETE ROOF DECK
- T.R. TOP OF NEW INSULATING CONCRETE DECK
- C.J. ROOF CONTROL JOINT SEE DETAIL 2/A3
- I.H. EXISTING INTAKE HOOD SEE DETAIL 6/A2
- R.V. NEW ALUMINUM ROOF VENT SEE DETAIL 2/A2
- P.P. NEW PITCH POCKET DETAIL SEE DETAIL 4/A2
- P.V. PLUMBING VENT SEE DETAIL 1/A2
- R.D. ROOF DRAIN SEE DETAIL 3/A2 & 3/A3
- S.F. NEW ALUM SPLASH PAN SET IN ROOF CEMENT
- EXIST WALL MOUNTED LIGHT AND CONDUIT TO BE REMOVED, RAISED AND REINSTALLED AT A HIGHER ELEVATION TO ACCOMMODATE NEW ELEVATION OF ROOF.
- TAPERED INSULATION OVER LIGHTWEIGHT FILL SEE 5/A-2

GENERAL ROOF NOTES

1. PROVIDE NEW 24 GAUGE ALUMINUM SPLASH PAN AT EACH EXIST DS AND HVAC RELIEF LINE FROM MECH. PENTHOUSES, SET IN ROOFING CEMENT
2. EXISTING NORTH WING OF ROOF HAS HAD THE ORIGINAL ROOF REMOVED AND A TEMPORARY ROOF INSTALLED. BALANCE OF ROOFS SHALL HAVE EXIST. ROOF AND INSULATION REMOVED DOWN TO CONC DECK, THESE ROOFS SHALL HAVE A (2) PLY 15" TEMP. ROOF INSTALLED.
3. METAL DECKED MECH PENTHOUSES PER NOTE #2 WITHOUT TEMP ROOF INSTALLED.
4. PLUMBING VENTS LESS THAN 12" FROM PARAPET WALL SHALL BE SHIFTED TO A MINIMUM OF 12" FROM WALL, CORE DRILL EXIST. CONC DECK AND REMOVE EXIST PLASTER CLG BELOW TO ACCOMPLISH WORK. PLASTER DOES NOT NEED TO BE REPLACED. (SEE PLAN FOR LOCATION)
5. ED AND T.R. ELEVATIONS APPLY TO EACH ROOF SEPARATELY, THEY ARE NOT RELATIVE TO EACH OTHER.
6. EXIST LIGHT FIXTURES AND CONDUIT LOCATED IN UPPER CUPOLA ROOFS SHALL BE REMOVED, RAISED AND REINSTALLED AFTER NEW ROOF HAS BEEN COMPLETED.
7. EXHAUST PENTHOUSES SHALL HAVE GALVANIZED EXHAUST FAN DUCT RAISED IF BOTTOM OF DUCT IS LESS THAN 12" ABOVE NEW ROOF ELEVATION.
8. ALL CRICKETS BEHIND EXHAUST FAN PENTHOUSES SHALL BE CONSTRUCTED FROM TAPERED PERLITE INSULATION (1/4"/FOOT).
9. WHERE EXISTING PENTHOUSES ARE REMOVED, CONTRACTOR SHALL INSTALL NEW ROOF CURBS, EXHAUST FANS, ELECTRICAL HOOK-UP DISCONNECTS, ETC., AND EXTEND AND HOOK-UP DUCTWORK AS REQUIRED.

EXHAUST FAN SCHEDULE

- EF-1 = ACME ENGINEERING & MANUF. CENTRI-MASTER #FAN 1035, 873 RPM, 1720 CFM. @ .125 SP, 1/3 H.P., 115V, 1Φ -
- EF-2 = ACME ENGINEERING & MANUF. CENTRI-MASTER #FAN 245H, 807 RPM, 5920 CFM. @ .125 SP, 3/4 H.P., 220V., 3Φ -
- EF-3 = SAME AS EF-1
- EF-4 = ACME ENGINEERING & MANUF. CENTRI-MASTER #FAN 200K, 1006 RPM, 4360 CFM. @ .125 SP, 1 1/2 H.P., 220V., 3Φ -
- EF-5 = SAME AS EF-1

REVISIONS	DATE
1	
2	
3	
4	
5	
6	
7	
8	
9	

ROOF REPLACEMENT FOR CHERRY HALL
BOWLING GREEN KENTUCKY

AS BUILT DATE

ROOF PLAN, NOTES AND LEGEND

DRAWN BY: J.P.D.
CHECKED BY: J.E.D.
ARE FILE NO. 96.50
DATE MARCH, 1996

JAMES E. DENTON ARCHITECT
36 WEST LAKE STREET
MADISONVILLE, KENTUCKY

COMMONWEALTH OF KENTUCKY
FINANCE AND ADMINISTRATION CABINET
DEPT. FOR FACILITIES MANAGEMENT
DIVISION OF ENGINEERING
FRANKFORT, KENTUCKY

DRAWING NO. A-1 OF 3

REVIEWED DIV. OF ENGR.

FOR INTENT ONLY
ENGR. FILE NO. R-202

JAMES E. DENTON ARCHITECT 19 KENTUCKY

AGENCY AUTHORIZED AGENT — APPROVED FOR PROGRAM CONCEPT ONLY — DATE 7/22/1996

MANAGER DIV. OF ENGR. — Robert W. Schaab — APPROVED FOR PROGRAM CONCEPT ONLY — DATE 7/24/96

R-3956

PLUMBING VENT DET. (1 / A-2)

SCALE: 1 1/2" = 1'-0"

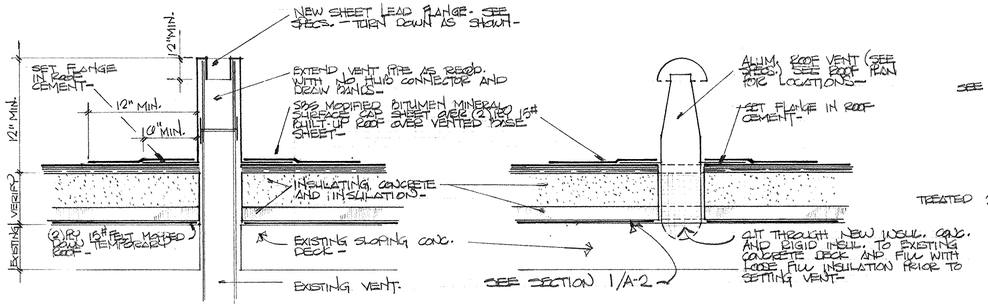

INSULATION VENT (2 / A-2)

SCALE: 1 1/2" = 1'-0"

ROOF DRAIN DETAIL (3 / A-2)

SCALE: 1 1/2" = 1'-0"

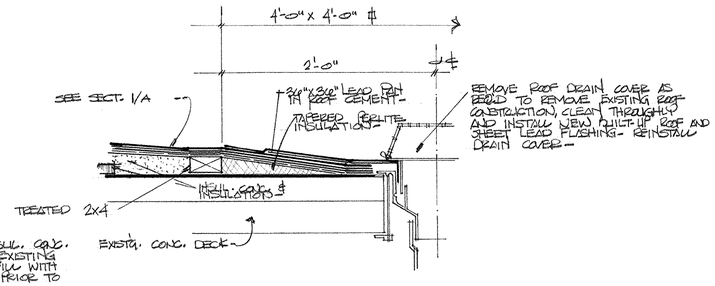

PITCH POCKET DETAIL (4 / A-2)

SCALE: 1 1/2" = 1'-0"

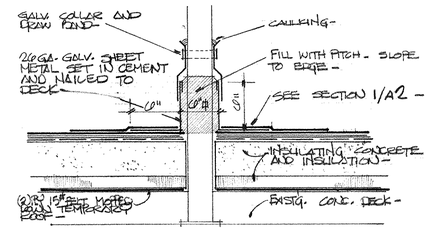

COOLING TOWER SUPPORT (5 / A-2)

SCALE: 1 1/2" = 1'-0"

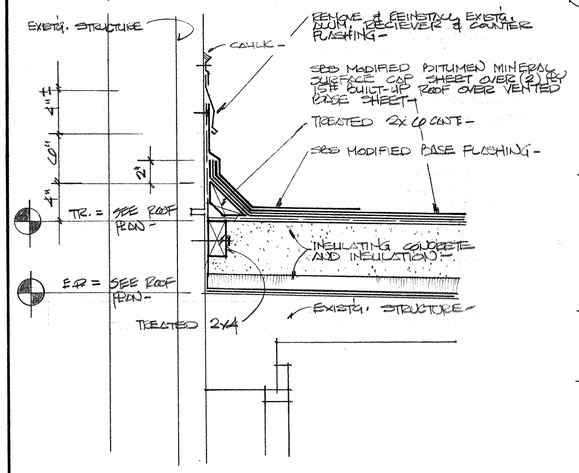

INTAKE HOOD DETAIL (6 / A-2)

SCALE: 3" = 1'-0"

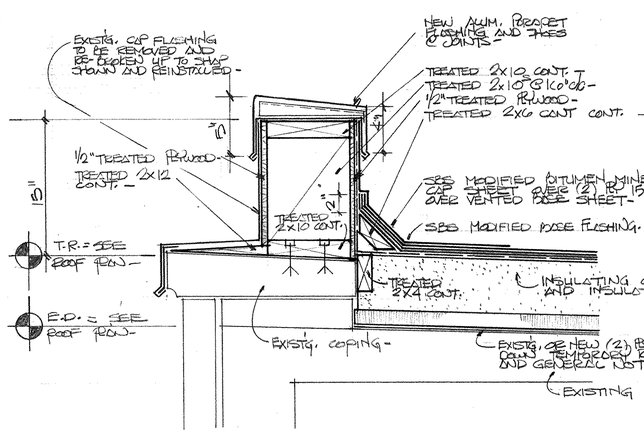

PENTHOUSE ROOF DETAIL (7 / A-2)

SCALE: 1 1/2" = 1'-0"

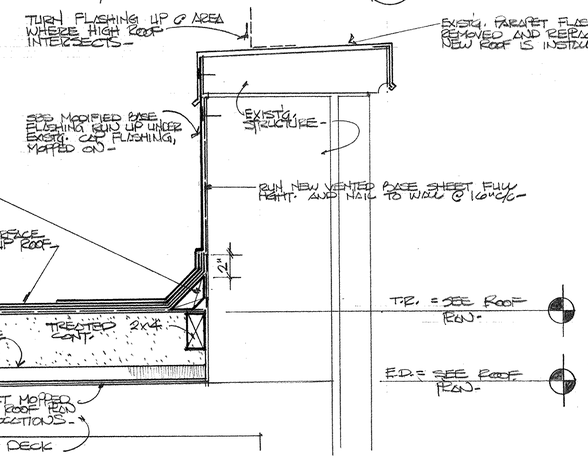

PENTHOUSE BASE DETAIL (8 / A-2)

SCALE: 1 1/2" = 1'-0"

TYP. BASE FLASHING DET. (9 / A-2)

SCALE: 1 1/2" = 1'-0"

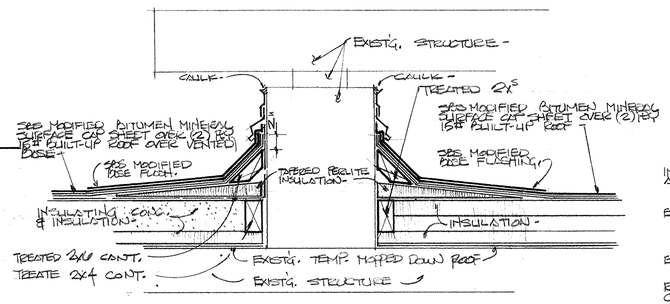

LOW PARAPET DETAIL (10 / A-2)

SCALE: 1 1/2" = 1'-0"

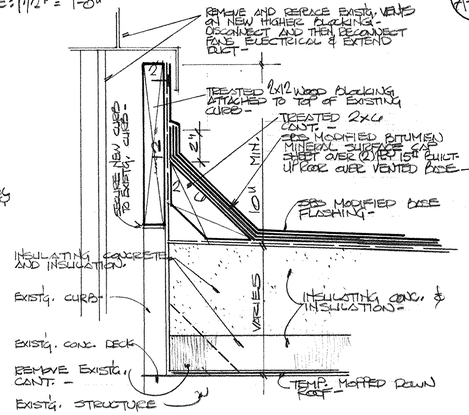

HIGH PARAPET DETAIL (11 / A-2)

SCALE: 1 1/2" = 1'-0"

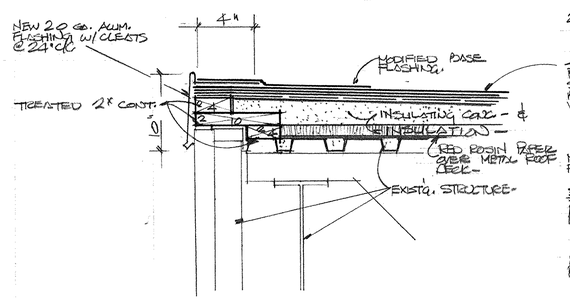

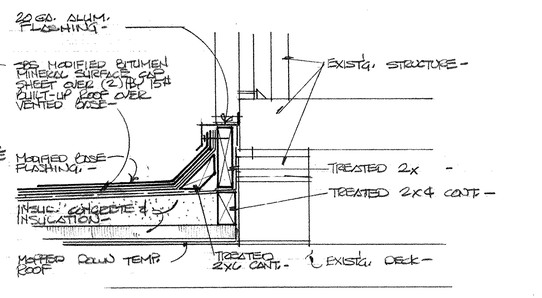

REVISIONS	DATE
1	
2	
3	
4	
5	
6	
7	
8	
9	

JAMES E. DENTON REGISTERED No. 1915 COMMONWEALTH OF KENTUCKY ARCHITECT

ROOF REPLACEMENT FOR CHERRY HALL
WESTERN STATE UNIVERSITY
BOWLING GREEN KENTUCKY

AS BUILT DATE

DRAWN BY: G.M.B.

CHECKED BY: JED

ABE FILE NO: 96-50

DATE: MARCH, 1996

SECTIONS AND DETAILS

JAMES E. DENTON ARCHITECT
36 WEST LAKE STREET
MADISONVILLE, KENTUCKY

COMMONWEALTH OF KENTUCKY
FINANCE AND ADMINISTRATION CABINET
DEPT. FOR FACILITIES MANAGEMENT
DIVISION OF ENGINEERING
FRANKFORT, KENTUCKY

DRAWING NO. A-2 OF 3

REVIEWED DIV. OF ENGR.

FOR INTENT ONLY

ENGR. FILE NO. R-202

AGENCY AUTHORIZED AGENT — APPROVED FOR PROGRAM CONCEPT ONLY — DATE 7/24/96

MANAGER DIV. OF ENGR. — APPROVED FOR PROGRAM CONCEPT ONLY — DATE 7/24/96

R-3957

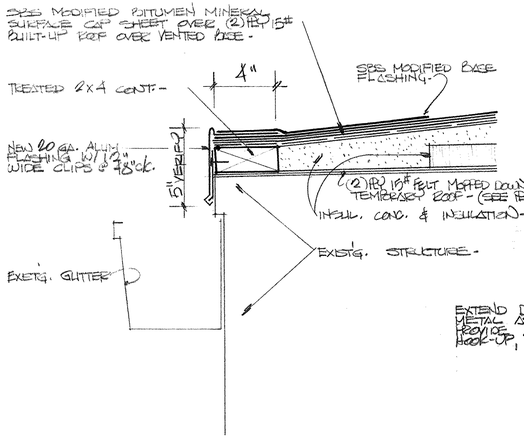

GUTTER DETAIL

SCALE: 3" = 1'-0"

1 / A-3

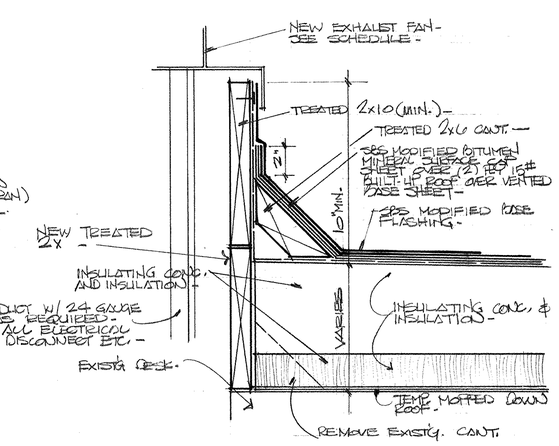

EXHAUST FAN CURB DETAIL

SCALE = 3" = 1'-0"

2 / A-3

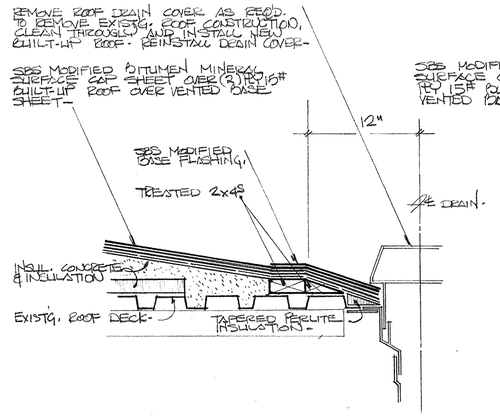

ROOF DRAIN DETAIL

SCALE = 1 1/2" = 1'-0"

3 / A-3

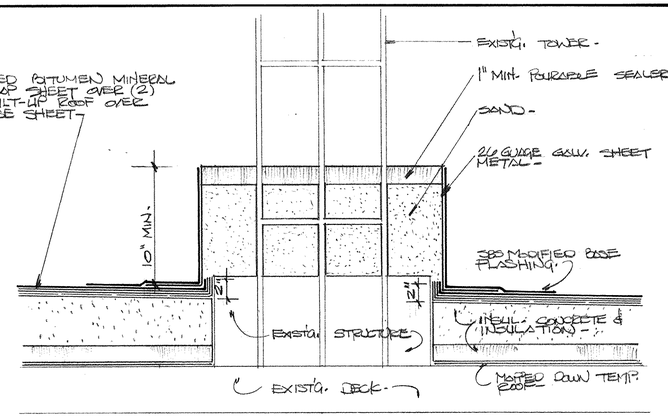

TOWER DETAIL

SCALE = 1 1/2" = 1'-0"

4 / A-3

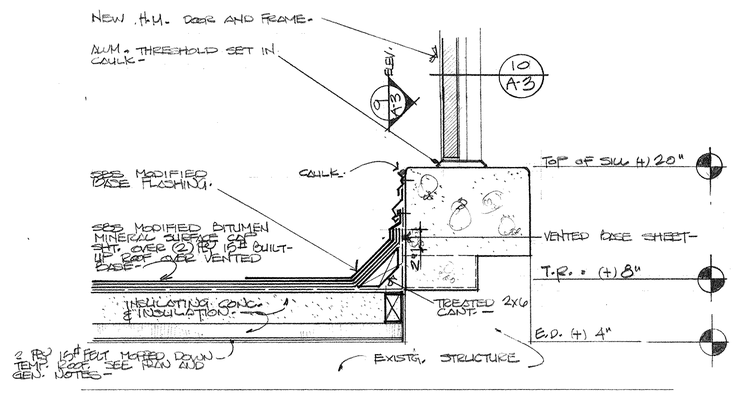

(NOT USED)
PENTHOUSE BASE DETAIL

SCALE: 1 1/2" = 1'-0"

5 / A-3

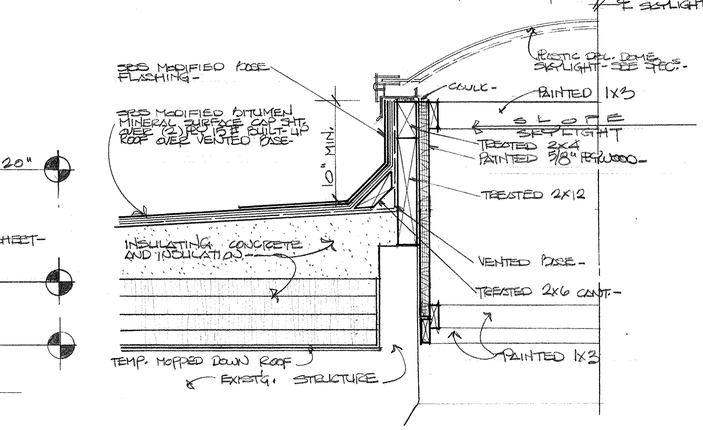

SKYLIGHT DETAIL

SCALE: 1 1/2" = 1'-0"

8 / A-3

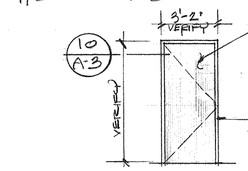

DOOR ELEVATION

SCALE: 1/4" = 1'-0"

9 / A-3

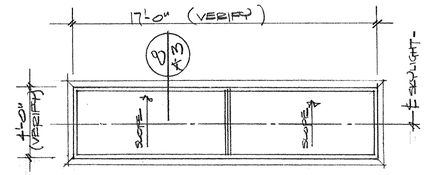

SKYLIGHT PLAN

SCALE = 1/4" = 1'-0"

SKYLIGHT TO BE = "NATURALITE/EP1, MODEL LOD (DOUBLE DOME) - SKYLIGHT SHALL BE FACTORY ASSEMBLED UNIT. CONSISTING OF TINTED INNER DOME & CLEAR OUTER DOME, .218" EXTRUDED ALUM. FRAME AND .032" EXTRUDED ALUM. RETAINING ANGLE - UNIFORM DESIGN LOAD CAPABILITY OF COMPLETE DOME AND FRAME SHALL MEET OR EXCEED 40 PSF SNOW LOAD - FIELD VERIFY EXACT SIZE PRIOR TO ORDER

(NOT USED)
DOOR SILL DETAIL

SCALE: 1 1/2" = 1'-0"

7 / A-3

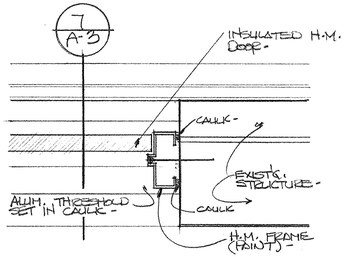

(NOT USED)
PENTHOUSE ROOF DETAIL

SCALE: 1 1/2" = 1'-0"

6 / A-3

JAMB DETAIL

SCALE = 1 1/2" = 1'-0"

10 / A-3

REVISIONS	DATE
1	
2	
3	
4	
5	
6	
7	
8	
9	

JAMES E. DENTON REGISTERED No. 1915 COMMONWEALTH OF KENTUCKY ARCHITECT

ROOF REPLACEMENT FOR CHERRY HALL
WESTERN STATE UNIVERSITY
BOWLING GREEN KENTUCKY

AS BUILT DATE

SECTIONS AND DETAILS

DRAWING NO. A-3 OF 3

DRAWN BY: J.M.B.
CHECKED BY: JED

JAMES E. DENTON ARCHITECT
36 WEST LAKE STREET
MADISONVILLE, KENTUCKY

ABE FILE NO. 96-50

DATE MARCH, 1996

COMMONWEALTH OF KENTUCKY
FINANCE AND ADMINISTRATION CABINET
DEPT. FOR FACILITIES MANAGEMENT
DIVISION OF ENGINEERING
FRANKFORT, KENTUCKY

REVIEWED DIV. OF ENGR.
FOR INTENT ONLY
ENGR. FILE NO. R-202

AGENCY AUTHORIZED AGENT — APPROVED FOR PROGRAM CONCEPT ONLY — DATE 7/25/96

MANAGER DIV. OF ENGR. — APPROVED FOR PROGRAM CONCEPT ONLY — DATE 7/24/96

R-3958

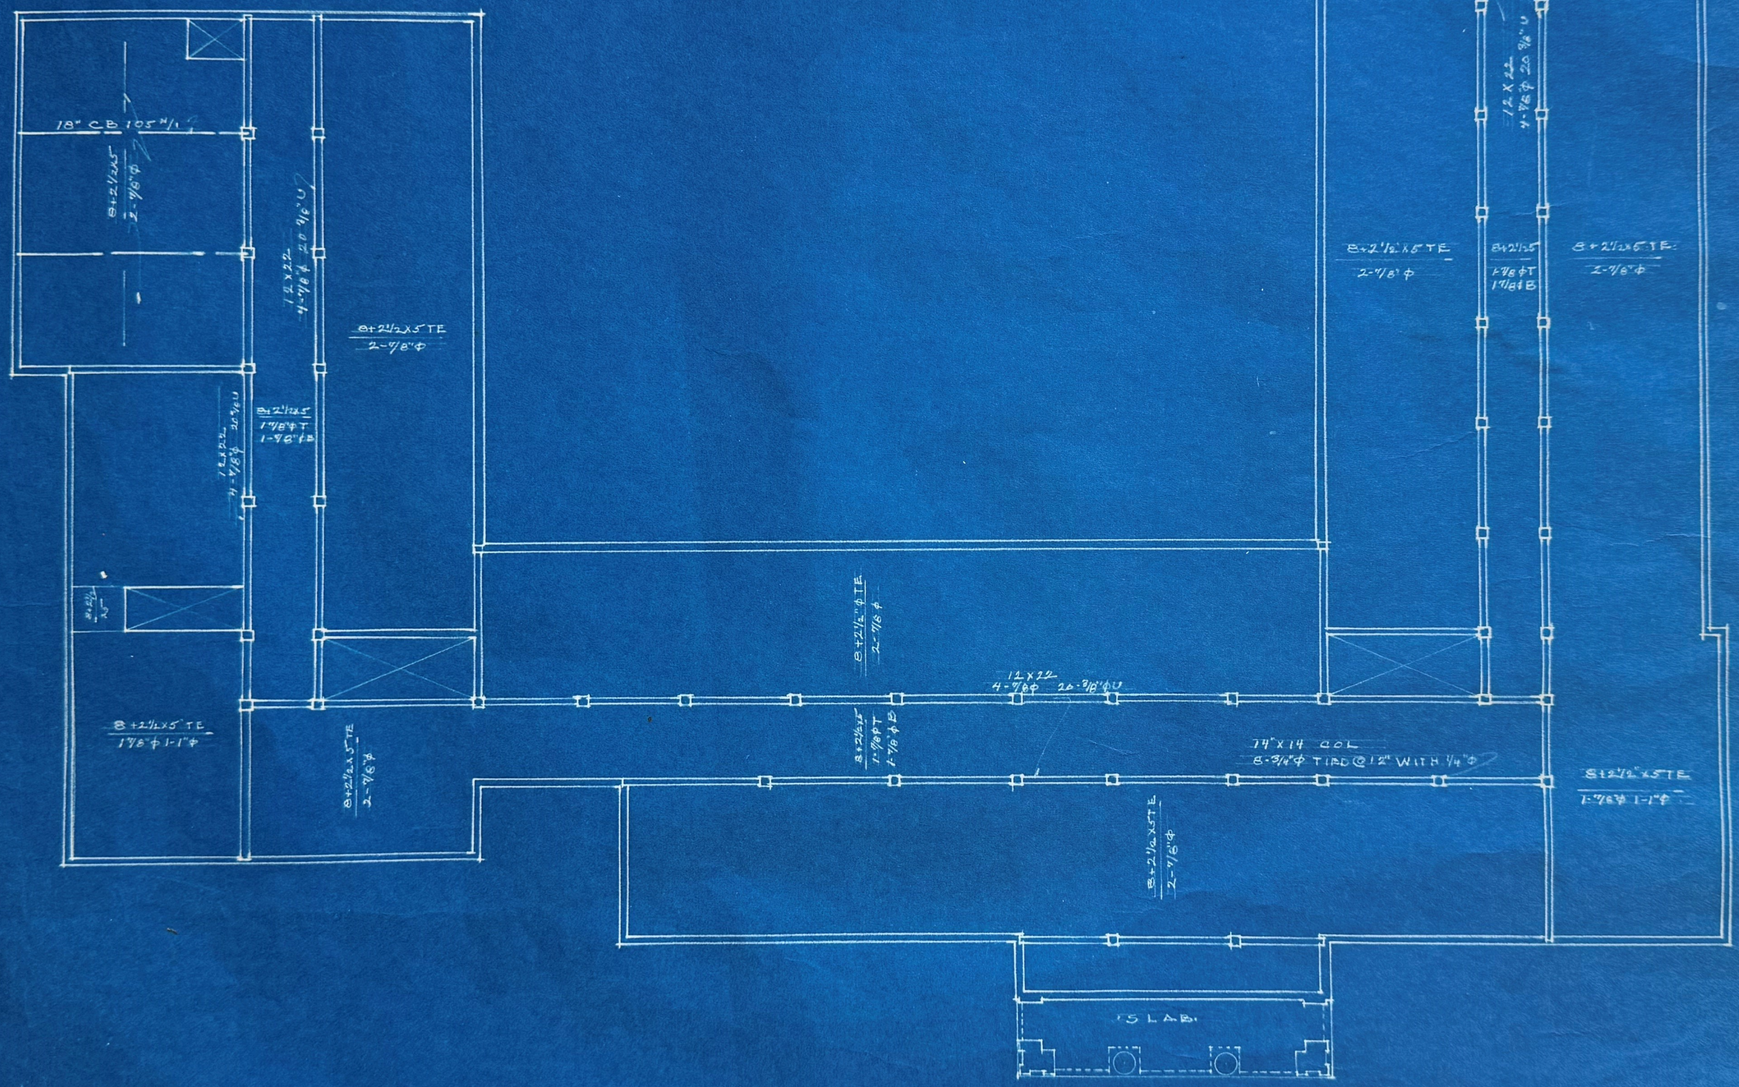

FIRST FLOOR FRAMING

1/16" = 1'-0"

NOTE

- STEEL 18,000 #/□"
- CONCRETE 750 #/□"
- REINFORCING 18,000 #/□"

CLASS ROOM BUILDING

WESTERN KENTUCKY STATE TEACHERS COLLEGE, BOWLING GREEN, KY. BRINTON B. DAVIS, ARCH. LOUISVILLE, KY.

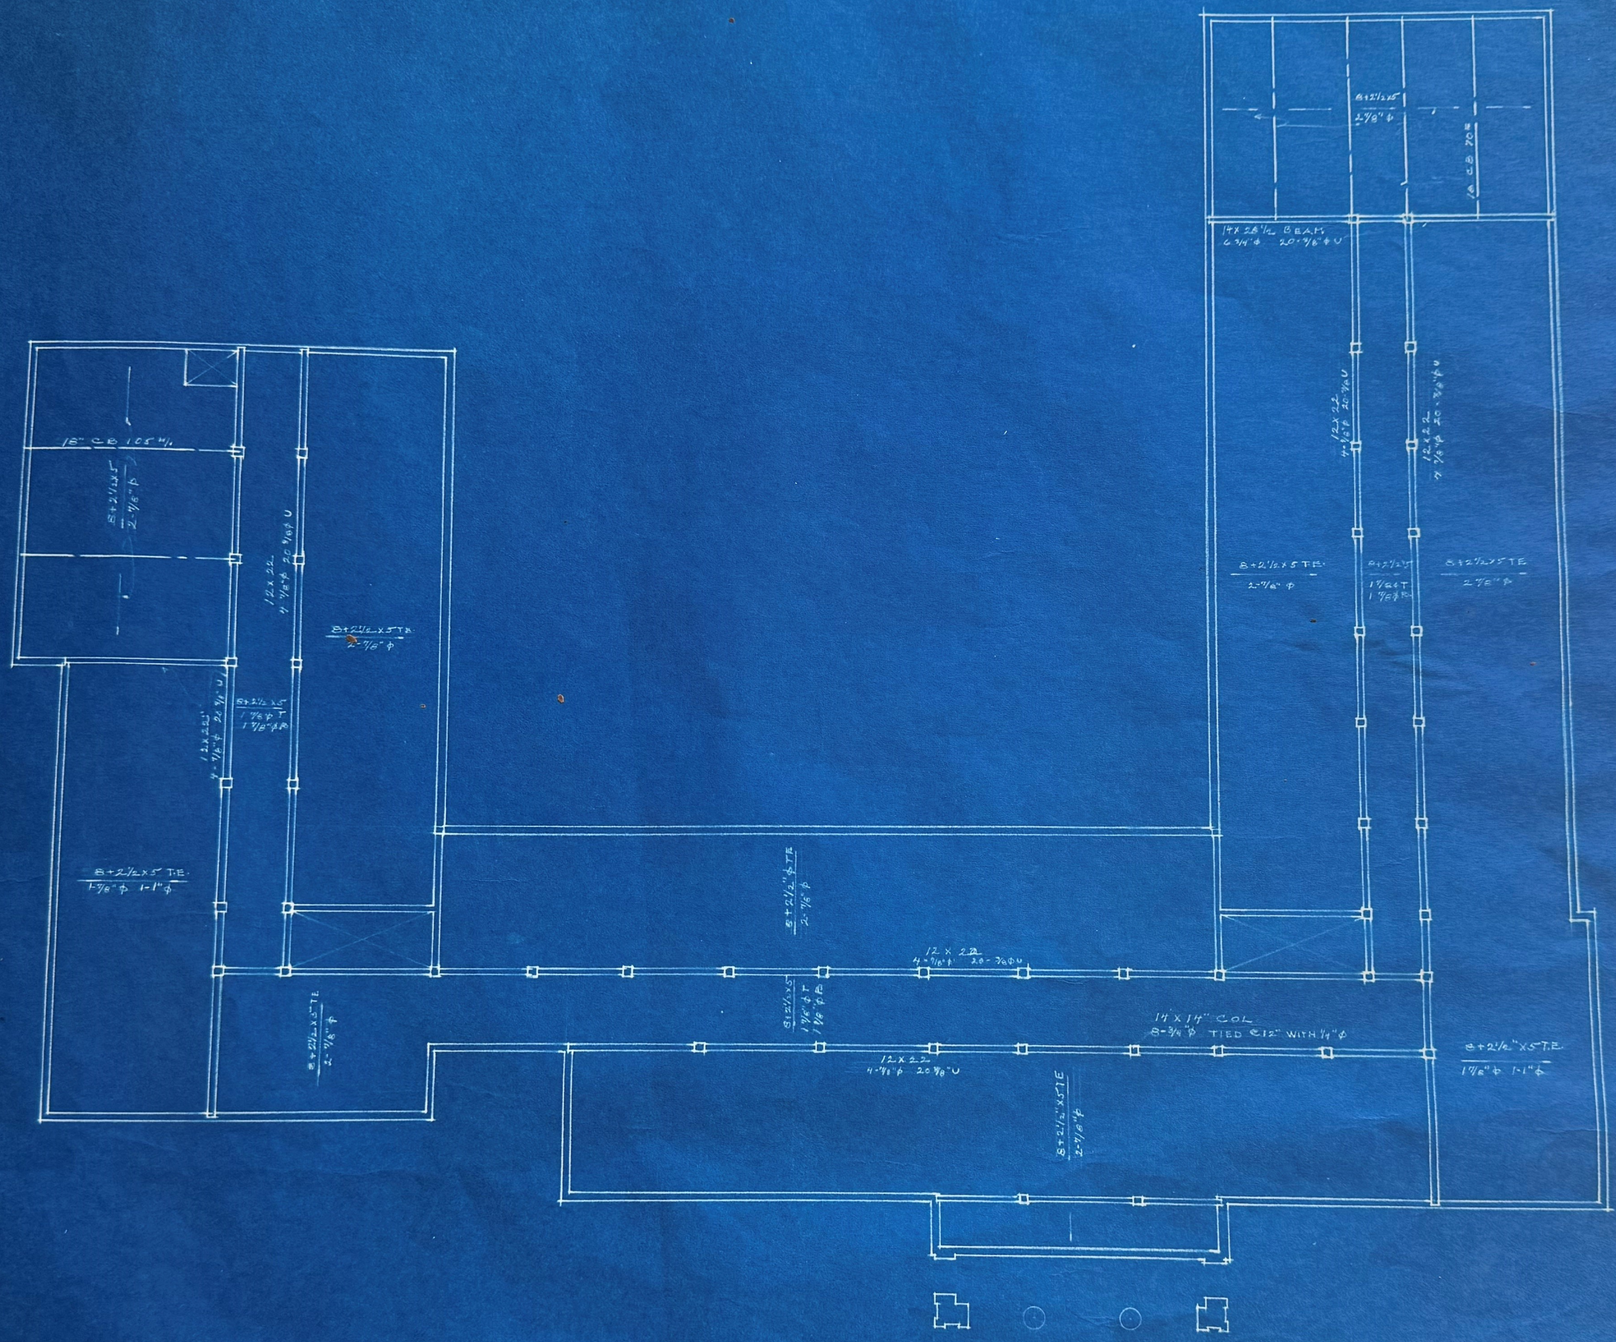

SECOND FLOOR FRAMING

1/16" = 1'-0"

CLASS ROOM BUILDING

WESTERN KENTUCKY STATE TEACHERS COLLEGE, BOWLING GREEN, KY. BRINTON B. DAVIS ARCH. LOUISVILLE, KY.

WESTERN · KENTUCKY STATE TEACHERS COLLEGE, BOWLING GREEN, KY. BRINTON B DAVIS ARCH LOUISVILLE, KY.

CLASS ROOM BUILDING

"THIRD FLOOR FRAMING"

1/16"=1'-0"

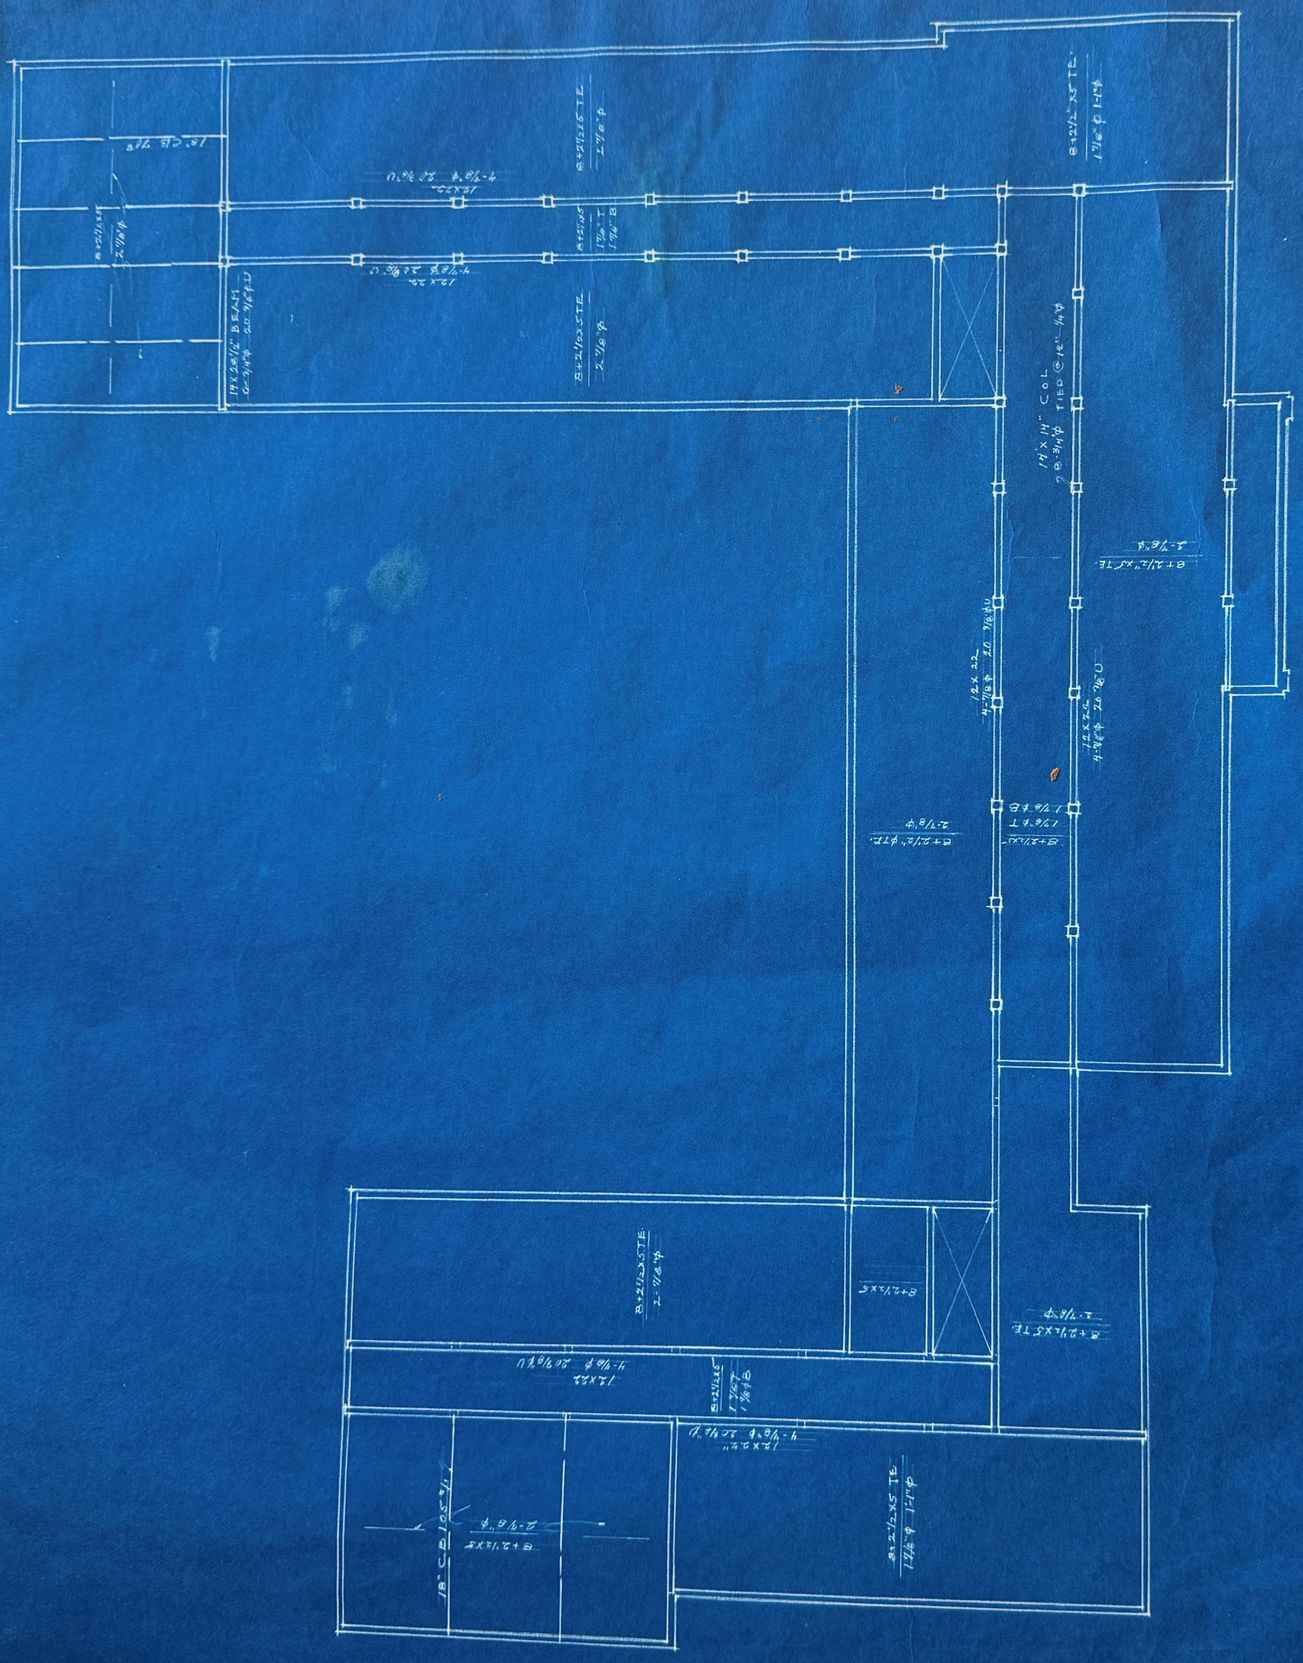

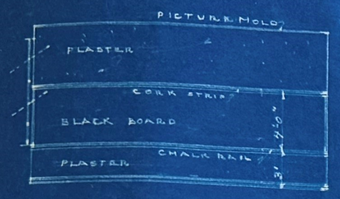

TYPICAL
BLACK BOARD INSTALATION
1/8"=1'-0"

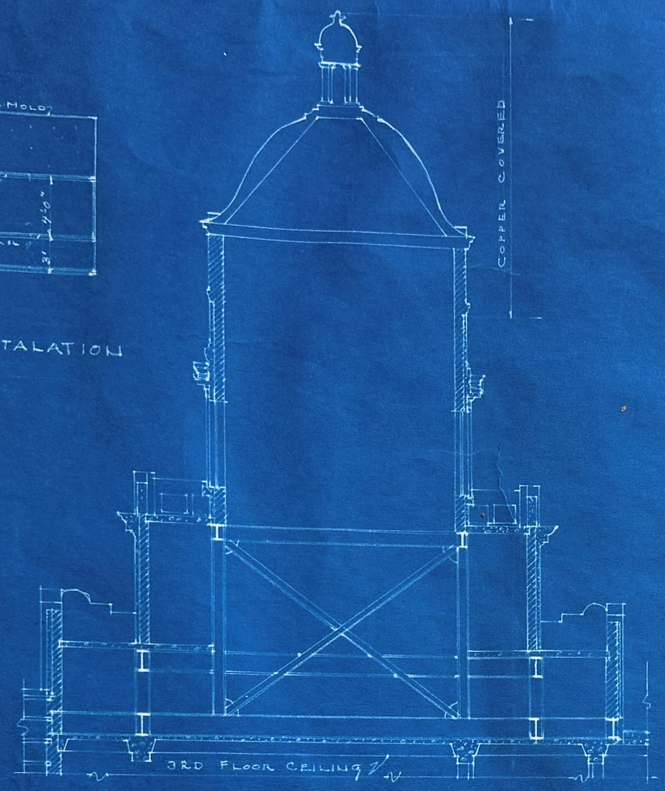

SECTION OF TOWER
1/16"=1'-0"

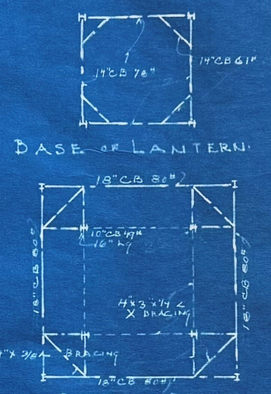

BASE OF LANTERN
FRAMING AT BASE OF DRUM

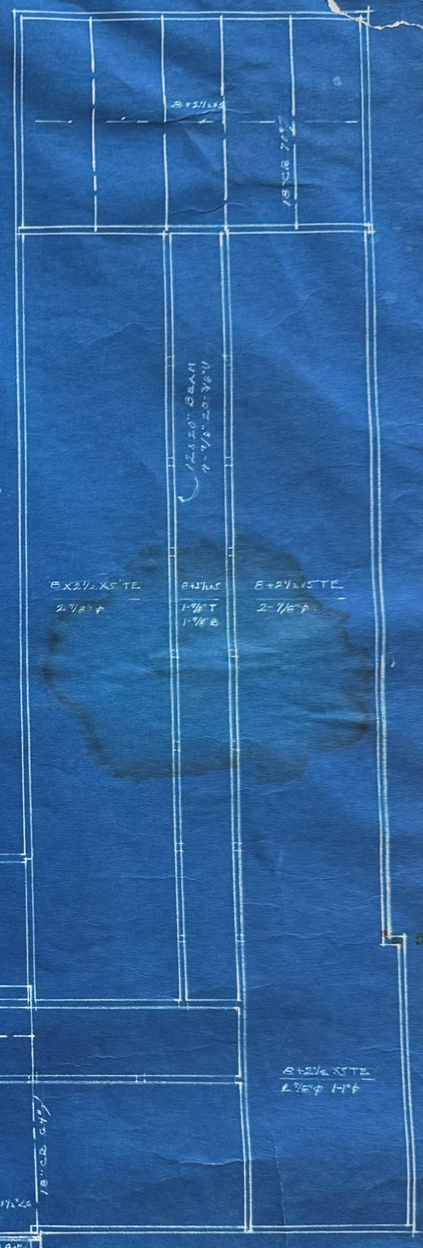

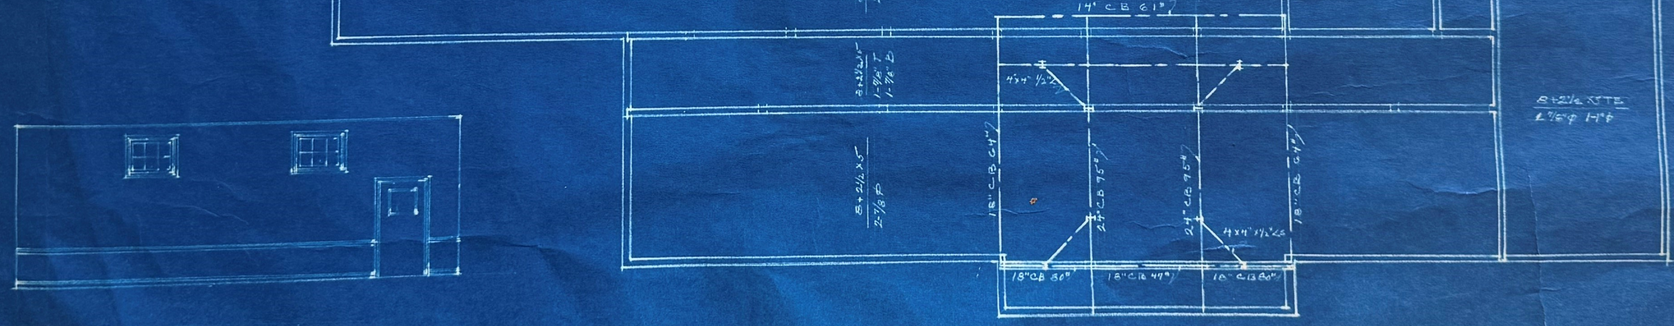

TYPICAL
SIDE WALL
1/8"=1'-0"

ROOF FRAMING PLAN
1/16"=1'-0"

CLASS ROOM BUILDING
WESTERN KENTUCKY STATE TEACHERS COLLEGE, BOWLING GREEN, KY. BRINTON B. DAVIS, ARCH. LOUISVILLE, KY.